


1] LOCATION OF WATER WELL: Fraction NC 1/4 SE 1/4 SE 1/4 Section Number 19 Township Number T 34 S Range Number R 32 EW
 County: Seward

Distance and direction from nearest town or city street address of well if located within city?
E. of Liberal on 54 to asphalt plant 1/2 S., 1E., 3/10N., W into

2] WATER WELL OWNER: Anadarko Cady A #2
 RR#, St. Address, Box #: Box 351 Board of Agriculture, Division of Water Resources
 City, State, ZIP Code: Liberal, Ks. 67905 Application Number: 960285

3] LOCATE WELL'S LOCATION WITH AN "X" IN SECTION BOX:

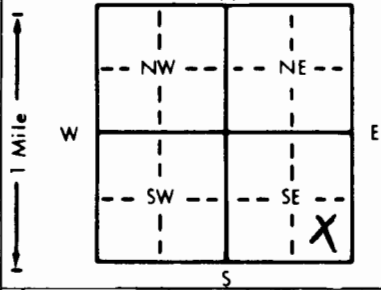

4] DEPTH OF COMPLETED WELL: 325 ft. ELEVATION: _____
 Depth(s) Groundwater Encountered 1. 200 ft. 2. _____ ft. 3. _____ ft.
 WELL'S STATIC WATER LEVEL 200 ft. below land surface measured on mo/day/yr _____
 Pump test data: Well water was 273 ft. after 1 hours pumping 100 gpm
 Est. Yield 100 gpm: Well water was _____ ft. after _____ hours pumping _____ gpm
 Bore Hole Diameter 11 in. to 325 ft., and _____ in. to _____ ft.
 WELL WATER TO BE USED AS:
 5 Public water supply 8 Air conditioning 11 Injection well
 1 Domestic 3 Feedlot 6 Oil field water supply 9 Dewatering 12 Other (Specify below)
 2 Irrigation 4 Industrial 7 Lawn and garden only 10 Monitoring well _____
 Was a chemical/bacteriological sample submitted to Department? Yes _____ No X _____; If yes, mo/day/yr sample was submitted _____
 Water Well Disinfected? Yes X No _____

5] TYPE OF BLANK CASING USED:
 1 Steel 3 RMP (SR) 5 Wrought iron 8 Concrete tile CASING JOINTS: Glued X Clamped _____
2 PVC 4 ABS 6 Asbestos-Cement 9 Other (specify below) Welded _____
 7 Fiberglass Threaded _____
 Blank casing diameter 6 in. to 325 ft., Dia _____ in. to _____ ft., Dia _____ in. to _____ ft.
 Casing height above land surface 24 in., weight 2.902 lbs./ft. Wall thickness or gauge No. 280 SDR 21
 TYPE OF SCREEN OR PERFORATION MATERIAL:
 1 Steel 3 Stainless steel 5 Fiberglass 7 PVC 10 Asbestos-cement
 2 Brass 4 Galvanized steel 6 Concrete tile 8 RMP (SR) 11 Other (specify) _____
 9 ABS 12 None used (open hole)
 SCREEN OR PERFORATION OPENINGS ARE:
 5 Gauzed wrapped 8 Saw cut 11 None (open hole)
 1 Continuous slot 3 Mill slot 6 Wire wrapped 9 Drilled holes
 2 Louvered shutter 4 Key punched 7 Torch cut 10 Other (specify) _____
 SCREEN-PERFORATED INTERVALS: From 240 ft. to 325 ft., From _____ ft. to _____ ft.
 From _____ ft. to _____ ft., From _____ ft. to _____ ft.
 GRAVEL PACK INTERVALS: From 140 ft. to 325 ft., From _____ ft. to _____ ft.
 From _____ ft. to _____ ft., From _____ ft. to _____ ft.

6] GROUT MATERIAL: 1 Neat cement 2 Cement grout 3 Bentonite 4 Other Hole Plug
 Grout Intervals: From 0 ft. to 16 ft., From _____ ft. to _____ ft., From _____ ft. to _____ ft.
 What is the nearest source of possible contamination:
 1 Septic tank 4 Lateral lines 7 Pit privy 10 Livestock pens 14 Abandoned water well
 2 Sewer lines 5 Cess pool 8 Sewage lagoon 11 Fuel storage 15 Oil well/Gas well
 3 Watertight sewer lines 6 Seepage pit 9 Feedyard 12 Fertilizer storage 16 Other (specify below)
 13 Insecticide storage _____
 Direction from well? West How many feet? 400

FROM	TO	LITHOLOGIC LOG	FROM	TO	PLUGGING INTERVALS
0	1	Surface			
1	9	Sandy Clay			
9	96	Clay & Sandy Clay			
96	317	Sand			
317	325	Clay			

7] CONTRACTOR'S OR LANDOWNER'S CERTIFICATION: This water well was (1) constructed, (2) reconstructed, or (3) plugged under my jurisdiction and was completed on (mo/day/year) 8-15-96 and this record is true to the best of my knowledge and belief. Kansas Water Well Contractor's License No. KWCL - 430 This Water Well Record was completed on (mo/day/yr) 8-15-96 under the business name of Howard Drlg Box 806, Beaver, OK. 73932 by (signature) _____

INSTRUCTIONS: Use typewriter or ball point pen. PLEASE PRESS FIRMLY and PRINT clearly. Please fill in blanks, underline or circle the correct answers. Send top three copies to Kansas Department of Health and Environment, Bureau of Water, Topeka, Kansas 66620-0001. Telephone: 913-296-5545. Send one to WATER WELL OWNER and retain one for your records.