


1 LOCATION OF WATER WELL: Fraction **C** 1/4 **SW** 1/4 **NW** 1/4 Section Number **7** Township Number **T 34 S** Range Number **R 32** **(EW)**
 County: **Seward**
 Distance and direction from nearest town or city street address of well if located within city?
Liberal; 3NE on 54 to Asphalt Plant 2 1/4N., & E into

2 WATER WELL OWNER: **Anadarko Petr.** #1 Hiebsch "A"
 RR#, St. Address, Box #: **P.O. Box 351** Board of Agriculture, Division of Water Resources
 City, State, ZIP Code: **Liberal, Ks 67905** Application Number: **970213**

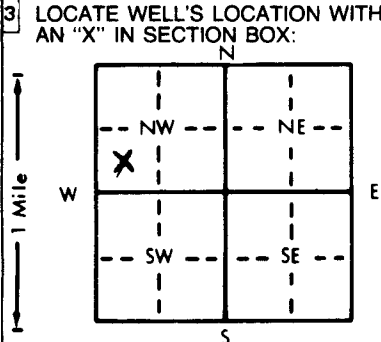

4 DEPTH OF COMPLETED WELL: **380** ft. ELEVATION:
 Depth(s) Groundwater Encountered 1. **220** ft. 2. ft. 3. ft.
 WELL'S STATIC WATER LEVEL **220** ft. below land surface measured on mo/day/yr **4-26-97**
 Pump test data: Well water was **273** ft. after **1** hours pumping **85** gpm
 Est. Yield **85** gpm: Well water was ft. after hours pumping gpm
 Bore Hole Diameter **11** in. to **380** ft., and in. to ft.
 WELL WATER TO BE USED AS:
 1 Domestic 3 Feedlot **6** Oil field water supply 9 Dewatering 12 Other (Specify below)
 2 Irrigation 4 Industrial 7 Lawn and garden only 10 Monitoring well
 Was a chemical/bacteriological sample submitted to Department? Yes.....No **X**.....; If yes, mo/day/yr sample was submitted
 Water Well Disinfected? Yes **X** No

5 TYPE OF BLANK CASING USED:
 1 Steel 3 RMP (SR) 5 Wrought iron 8 Concrete tile CASING JOINTS: Glued **X** Clamped
2 PVC 4 ABS 6 Asbestos-Cement 9 Other (specify below) Welded
 7 Fiberglass Threaded.....
 Blank casing diameter **6** in. to **380** ft., Dia in. to ft., Dia in. to ft.
 Casing height above land surface **24** in., weight **2.902** lbs./ft. Wall thickness or gauge No. **281** SDR **21**
 TYPE OF SCREEN OR PERFORATION MATERIAL:
 1 Steel 3 Stainless steel 5 Fiberglass **7** PVC 10 Asbestos-cement
 2 Brass 4 Galvanized steel 6 Concrete tile 8 RMP (SR) 11 Other (specify)
 12 None used (open hole)
 SCREEN OR PERFORATION OPENINGS ARE:
 1 Continuous slot 3 Mill slot 5 Gauzed wrapped **8** Saw cut 11 None (open hole)
 2 Louvered shutter 4 Key punched 6 Wire wrapped 9 Drilled holes
 7 Torch cut 10 Other (specify)
 SCREEN-PERFORATED INTERVALS: From **280** ft. to **380** ft., From ft. to ft.
 From ft. to ft., From ft. to ft.
 GRAVEL PACK INTERVALS: From **140** ft. to **380** ft., From ft. to ft.
 From ft. to ft., From ft. to ft.

6 GROUT MATERIAL: **1** Neat cement 2 Cement grout 3 Bentonite **4** Other **Hole Plug**
 Grout Intervals: From **0** ft. to **20** ft., From ft. to ft., From ft. to ft.
 What is the nearest source of possible contamination:
 1 Septic tank 4 Lateral lines 7 Pit privy 10 Livestock pens 14 Abandoned water well
 2 Sewer lines 5 Cess pool 8 Sewage lagoon 11 Fuel storage **15** Oil well/Gas well
 3 Watertight sewer lines 6 Seepage-pit 9 Feedyard 12 Fertilizer storage 16 Other (specify below)
 13 Insecticide storage
 Direction from well? **South** How many feet? **100**

FROM	TO	LITHOLOGIC LOG	FROM	TO	PLUGGING INTERVALS
0	8	Sand			
8	70	Sandy Clay / Clay			
70	85	Sand			
85	108	Sandy Clay / Clay			
108	125	Sand			
125	140	Clay			
140	300	Sand & Gravel			
300	314	Sandy Clay / Sand STreaks			
314	320	Sand			
320	330	Sandy Clay / Sand Streaks			
330	376	Sand			
376	380	Yellow Clay			

7 CONTRACTOR'S OR LANDOWNER'S CERTIFICATION: This water well was **(1)** constructed, (2) reconstructed, or (3) plugged under my jurisdiction and was completed on (mo/day/year) **4-26-97** and this record is true to the best of my knowledge and belief. Kansas Water Well Contractor's License No. **KWCL - 430** This Water Well Record was completed on (mo/day/yr) **4-26-97** under the business name of **Howard Drlg. Box 806 Beaver Ok 73932** by (signature) *[Signature]*

INSTRUCTIONS: Use typewriter or ball point pen. PLEASE PRESS FIRMLY and PRINT clearly. Please fill in blanks, underline or circle the correct answers. Send top three copies to Kansas Department of Health and Environment, Bureau of Water, Topeka, Kansas 66620-0001. Telephone: 913-296-5545. Send one to WATER WELL OWNER and retain one for your records.