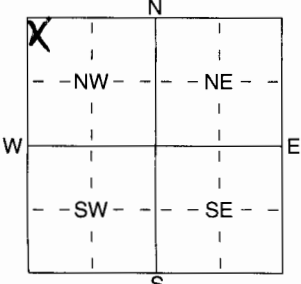


1 LOCATION OF WATER WELL: Fraction NW 1/4 NW 1/4 NW 1/4 Section Number 21 Township Number T 34 S Range Number R 32 E/W
 County: Seward

Distance and direction from nearest town or city street address of well if located within city? Liberal, Ks: from 6 way stop light on Hwy 54 & 83 bypass, 5E on Bluebell Rd, 2.5 N on Arkalon to N Ark Lane E approx. 1500' to lot 16

2 WATER WELL OWNER: Star Development L.C. Lot 16
 RR#, St. Address, Box # : Rt. 2 Box 294 Board of Agriculture, Division of Water Resources
 City, State, ZIP Code : Liberal, Ks 67901 Application Number:

3 LOCATE WELL'S LOCATION WITH AN "X" IN SECTION BOX:

 4 DEPTH OF COMPLETED WELL 260 ft. ELEVATION:
 Depth(s) Groundwater Encountered 1 205 ft. 2 _____ ft. 3 _____ ft.
 WELL'S STATIC WATER LEVEL 205 ft. below land surface measured on mo/day/yr 8-20-05
 Pump test data: Well water was 2.16 ft. after 1 hours pumping 90 gpm
 Est. Yield 90 gpm: Well water was _____ ft. after _____ hours pumping _____ gpm
 WELL WATER TO BE USED AS: 5 Public water supply 8 Air conditioning 11 Injection well
 Domestic 3 Feedlot 6 Oil field water supply 9 Dewatering 12 Other (Specify below)
 Irrigation 4 Industrial 7 Domestic (lawn & garden) 10 Monitoring well _____
 Was a chemical/bacteriological sample submitted to Department? Yes _____ No ; If yes, mo/day/yr sample was submitted
 Water Well Disinfected? Yes No _____

5 TYPE OF BLANK CASING USED:
 1 Steel 3 RMP (SR) 5 Wrought iron 8 Concrete tile CASING JOINTS: Glued Clamped _____
 2 PVC 4 ABS 6 Asbestos-Cement 9 Other (specify below) Welded _____
 Blank casing diameter 5 in. to 260 ft. Dia _____ in. to _____ ft. Dia _____ in. to _____ ft.
 Casing height above land surface 24 in., weight 3,706 lbs./ft. Wall thickness or guage No SDR 21.316
 TYPE OF SCREEN OR PERFORATION MATERIAL:
 1 Steel 3 Stainless Steel 5 Fiberglass 7 PVC 10 Asbestos-Cement
 2 Brass 4 Galvanized Steel 6 Concrete tile 8 RMP (SR) 11 Other (Specify) _____
 9 ABS 12 None used (open hole)
 SCREEN OR PERFORATION OPENINGS ARE:
 1 Continuous slot 3 Mill slot 5 Gauzed wrapped 8 Saw cut 11 None (open hole)
 2 Louvered shutter 4 Key punched 6 Wire wrapped 9 Drilled holes
 7 Torch cut 10 Other (specify) _____ ft.
 SCREEN-PERFORATED INTERVALS: From 240 ft. to 260 ft. From _____ ft. to _____ ft.
 GRAVEL PACK INTERVALS: From 60 ft. to 260 ft. From _____ ft. to _____ ft.

6 GROUT MATERIAL: 1 Neat cement 2 Cement grout 3 Bentonite 4 Other Hole plug
 Grout Intervals: From 1 ft. to 25 ft., From _____ ft. to _____ ft., From _____ ft. to _____ ft.
 What is the nearest source of possible contamination:
 1 Septic tank 4 Lateral lines 7 Pit privy 10 Livestock pens 14 Abandoned water well
 2 Sewer lines 5 Cess pool 8 Sewage lagoon 11 Fuel storage 15 Oil well/Gas well
 3 Watertight sewer lines 6 Seepage pit 9 Feedyard 12 Fertilizer storage 16 Other (specify below)
 13 Insecticide storage _____
 Direction from well? _____ How many feet? _____

FROM	TO	LITHOLOGIC LOG	FROM	TO	PLUGGING INTERVALS
0	3	Surface			
3	103	Clay			
103	186	Sand			
186	195	Clay			
195	258	Sand			
258	260	Clay			

7 CONTRACTOR'S OR LANDOWNER'S CERTIFICATION: This water well was (1) constructed, (2) reconstructed, or (3) plugged under my jurisdiction and was completed on (mo/day/year) 8-20-05 and this record is true to the best of my knowledge and belief. Kansas Water Well Contractor's Licence No. KWWCL430 This Water Well Record was completed on (mo/day/yr) 8-20-05 under the business name of Howard Drilling Co Box 806 Beaver, Ok 73932 by (signature) [Signature]