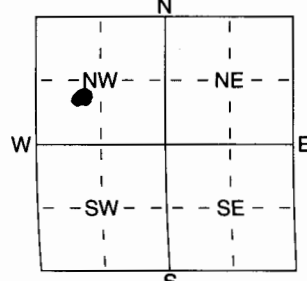


1 LOCATION OF WATER WELL: Fraction NE 1/4 SW 1/4 NW 1/4 Section Number 21 Township Number T 34 S Range Number R 32 EW
 County: Seward

Distance and direction from nearest town or city street address of well if located within city?
Liberal: 5 E on Bluebell Rd.--2 1/2 N-- E to curve and SW into--

2 WATER WELL OWNER: Star Development Lot #17
 RR#, St. Address, Box # : Rt. 2, Box 294
 City, State, ZIP Code : Liberal, KS 67901 Board of Agriculture, Division of Water Resources
 Application Number:

3 LOCATE WELL'S LOCATION WITH AN "X" IN SECTION BOX:

 4 DEPTH OF COMPLETED WELL 260 ft. ELEVATION:
 Depth(s) Groundwater Encountered 1 205 ft. 2 ft. 3 ft.
 WELL'S STATIC WATER LEVEL 205 ft. below land surface measured on mo/day/yr 11-16-05
 Pump test data: Well water was 225 ft. after hours pumping 7.5 gpm
 Est. Yield 7.5 gpm: Well water was ft. after hours pumping gpm
 WELL WATER TO BE USED AS: 5 Public water supply 8 Air conditioning 11 Injection well
 1 Domestic 3 Feedlot 6 Oil field water supply 9 Dewatering 12 Other (Specify below)
 2 Irrigation 4 Industrial 7 Domestic (lawn & garden) 10 Monitoring well
 Was a chemical/bacteriological sample submitted to Department? Yes No X ; If yes, mo/day/yr sample was submitted
 Water Well Disinfected? Yes X No

5 TYPE OF BLANK CASING USED:
 1 Steel 3 RMP (SR) 5 Wrought iron 8 Concrete tile CASING JOINTS: Glued X Clamped
 2 PVC 4 ABS 6 Asbestos-Cement 9 Other (specify below) Welded
 7 Fiberglass Threaded
 Blank casing diameter 5 in. to 220 ft. Dia in. to ft. Dia in. to ft.
 Casing height above land surface 24 in., weight 3.604 lbs./ft. Wall thickness or guage No. SDR. 21 316
 TYPE OF SCREEN OR PERFORATION MATERIAL:
 1 Steel 3 Stainless Steel 5 Fiberglass 7 PVC 10 Asbestos-Cement
 2 Brass 4 Galvanized Steel 6 Concrete tile 8 RMP (SR) 11 Other (Specify)
 9 ABS 12 None used (open hole)
 SCREEN OR PERFORATION OPENINGS ARE:
 1 Continuous slot 3 Mill slot 5 Gauzed wrapped 8 Saw cut 11 None (open hole)
 2 Louvered shutter 4 Key punched 6 Wire wrapped 9 Drilled holes
 7 Torch cut 10 Other (specify) ft.
 SCREEN-PERFORATED INTERVALS: From 220 ft. to 260 ft., From ft. to ft.
 GRAVEL PACK INTERVALS: From 100 ft. to 260 ft., From ft. to ft.

6 GROUT MATERIAL: 1 Neat cement 2 Cement grout 3 Bentonite 4 Other Hole Plug
 Grout Intervals: From ft. to 25 ft., From ft. to ft., From ft. to ft.
 What is the nearest source of possible contamination:
 1 Septic tank 4 Lateral lines 7 Pit privy 10 Livestock pens 14 Abandoned water well
 2 Sewer lines 5 Cess pool 8 Sewage lagoon 11 Fuel storage 15 Oil well/Gas well
 3 Watertight sewer lines 6 Seepage pit 9 Feedyard 12 Fertilizer storage 16 Other (specify below)
 13 Insecticide storage
 Direction from well? How many feet?

FROM	TO	LITHOLOGIC LOG	FROM	TO	PLUGGING INTERVALS
0	1	Surface			
1	18	Sandy Clay			
18	53	Clay			
53	69	Sandy Clay			
69	90	Clay			
90	108	Sandy Clay			
108	174	Sand			
174	184	Sandy Clay			
184	198	Clay			
198	257	Sand			
257	260	Clay			

7 CONTRACTOR'S OR LANDOWNER'S CERTIFICATION: This water well was (1) constructed, (2) reconstructed, or (3) plugged under my jurisdiction and was completed on (mo/day/year) 11-16-05 and this record is true to the best of my knowledge and belief. Kansas Water Well Contractor's Licence No KWCL-430 This Water Well Record was completed on (mo/day/yr) 11-16-05 under the business name of Howard Drilling Co. Box 806 Beaver, OK 73932 by (signature) *Howard Drilling Co.*