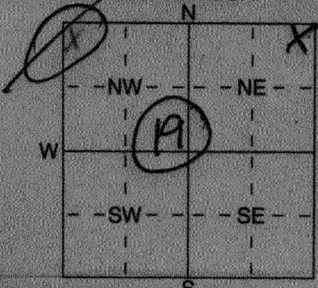


NE/NE/NE Section 19

WATER WELL RECORD Form WWC-5 KSA 82a-1212 ID No.

1 LOCATION OF WATER WELL: Fraction 1/4 Section Number 20 Township Number T 34 S Range Number R 12 E/W E/W
 County: Seward
 Distance and direction from nearest town or city street address of well if located within city? Liberal, Ks: Intersection of Hwy 83 & 54
5 N/E on Hwy 54 Rd 3 (Salley) & 54 .13E on dirt Rd 3S 500' along fence & W 40' marked flags

2 WATER WELL OWNER: Development E.C. Nancy Little RV Park
 RR#, St. Address, Box # : Rt. 2 Box 234 western Star RV Ranch
 City, State, ZIP Code : Liberal, Ks 67301 Board of Agriculture, Division of Water Resources
 Application Number:

3 LOCATE WELL'S LOCATION WITH AN "X" IN SECTION BOX:

 4 DEPTH OF COMPLETED WELL: 260 ft. ELEVATION: _____
 Depth(s) Groundwater Encountered 1 204 ft. 2 _____ ft. 3 _____ ft.
 WELL'S STATIC WATER LEVEL: 204 ft. below land surface measured on mo/day/yr _____
 Pump test data: Well water was _____ ft. after _____ hours pumping _____ gpm
 Est. Yield _____ gpm: Well water was _____ ft. after _____ hours pumping _____ gpm
 WELL WATER TO BE USED AS:
 1 Domestic 3 Feedlot 5 Public water supply 8 Air conditioning 11 Injection well
 2 Irrigation 4 Industrial 6 Oil field water supply 9 Dewatering 12 Other (Specify below)
 7 Domestic (lawn & garden) 10 Monitoring well _____
 Was a chemical/bacteriological sample submitted to Department? Yes _____ No X; If yes, mo/day/yr sample was submitted
 Water Well Disinfected? Yes X No _____

5 TYPE OF BLANK CASING USED:
 1 Steel 3 RMP (SR) 5 Wrought iron 8 Concrete tile CASING JOINTS: Glued X Clamped _____
 2 PVC 4 ABS 6 Asbestos-Cement 9 Other (specify below) Welded _____
 7 Fiberglass Threaded _____
 Blank casing diameter _____ in. to _____ ft., Dia _____ in. to _____ ft., Dia _____ in. to _____ ft.
 Casing height above land surface _____ in., weight _____ lbs./ft. Wall thickness or gauge No. SDR 21.316
 TYPE OF SCREEN OR PERFORATION MATERIAL:
 1 Steel 3 Stainless Steel 5 Fiberglass 7 PVC 10 Asbestos-Cement
 2 Brass 4 Galvanized Steel 6 Concrete tile 8 RMP (SR) 11 Other (Specify) _____
 9 ABS 12 None used (open hole) _____
 SCREEN OR PERFORATION OPENINGS ARE:
 1 Continuous slot 3 Mill slot 5 Gauzed wrapped 8 Saw cut 11 None (open hole)
 2 Louvered shutter 4 Key punched 6 Wire wrapped 9 Drilled holes
 7 Torch cut 10 Other (specify) _____ ft.
 SCREEN-PERFORATED INTERVALS: From 240 ft. to 250 ft. From _____ ft. to _____ ft.
 From _____ ft. to _____ ft. From _____ ft. to _____ ft.
 GRAVEL PACK INTERVALS: From 240 ft. to 2260 ft. From _____ ft. to _____ ft.
 From _____ ft. to _____ ft. From _____ ft. to _____ ft.

6 GROUT MATERIAL: 1 Neat cement 2 Cement grout 3 Bentonite 4 Other NOTE PLUG
 Grout Intervals: From _____ ft. to 25 ft. From _____ ft. to _____ ft. From _____ ft. to _____ ft.
 What is the nearest source of possible contamination:
 1 Septic tank 4 Lateral lines 7 Pit privy 10 Livestock pens 14 Abandoned water well
 2 Sewer lines 5 Cess pool 8 Sewage lagoon 11 Fuel storage 15 Oil well/Gas well
 3 Watertight sewer lines 6 Seepage pit 9 Feedyard 12 Fertilizer storage 16 Other (specify below) _____
 13 Insecticide storage _____
 Direction from well? _____ How many feet? _____

FROM	TO	LITHOLOGIC LOG	FROM	TO	PLUGGING INTERVALS
0	2	Surface			
2	8	Sandy clay			
8	104	Clay and sandy clay			
104	121	Sand			
121	136	Clay			
136	156	Sand			
156	204	Clay			
204	259	Sand			
259	260	Clay			

CORRECTED COPY

RECEIVED
 SEP 04 2007

BUREAU OF WATER

7 CONTRACTOR'S OR LANDOWNER'S CERTIFICATION: This water well was (1) constructed, (2) reconstructed, or (3) plugged under my jurisdiction and was completed on (mo/day/year) _____ and this record is true to the best of my knowledge and belief. Kansas Water Well Contractor's Licence No. _____ This Water Well Record was completed on (mo/day/yr) _____ under the business name of _____ by (signature) _____

INSTRUCTIONS: Use typewriter or ball point pen. PLEASE PRESS FIRMLY and PRINT clearly. Please fill in blanks, underline or circle the correct answers. Send top three copies to Kansas Department of Health and Environment, Bureau of Water, Geology Section, 1000 SW Jackson St., Suite 420, Topeka, Kansas 66612-1367. Telephone 785-296-5522. Send one to WATER WELL OWNER and retain one for your records. Fee of \$5.00 for each constructed well.

1 LOCATION OF WATER WELL: County: <u>Seward</u>	Fraction <u>NW 1/4 NW 1/4 NW 1/4</u>	Section Number <u>20</u>	Township Number T <u>34</u> S	Range Number R <u>32</u> <u>E/W</u>
--	---	-----------------------------	----------------------------------	--

Distance and direction from nearest town or city street address of well if located within city? Liberal Ks: Intersection of Hwy 83 & 54
5 N/E on Hwy 54 Rd 3 (Salley) & 54 .15E on dirt Rd 3S 500' along fence & W 40' marked flags

2 WATER WELL OWNER: RR#, St. Address, Box # : City, State, ZIP Code :	<u>Star Development L.C. Nancy Little RV Park</u> <u>Rt. 2 Box 294</u> <u>Liberal, Ks 67901</u>	Board of Agriculture, Division of Water Resources Application Number:
---	---	--

3 LOCATE WELL'S LOCATION WITH AN "X" IN SECTION BOX:	4 DEPTH OF COMPLETED WELL <u>260</u> ft. ELEVATION:
--	---

Depth(s) Groundwater Encountered 1 206 ft. 2 ft. 3 ft.

WELL'S STATIC WATER LEVEL 206 ft. below land surface measured on mo/day/yr 6-5-05

Pump test data: Well water was 211 ft. after 1 hours pumping 100 gpm

Est. Yield 100 gpm: Well water was ft. after hours pumping gpm

WELL WATER TO BE USED AS:

<input checked="" type="radio"/> 1 Domestic	<input type="radio"/> 3 Feedlot	<input type="radio"/> 6 Oil field water supply	<input type="radio"/> 9 Dewatering	<input type="radio"/> 12 Other (Specify below)
<input type="radio"/> 2 Irrigation	<input type="radio"/> 4 Industrial	<input type="radio"/> 7 Domestic (lawn & garden)	<input type="radio"/> 10 Monitoring well	

Was a chemical/bacteriological sample submitted to Department? Yes No ; If yes, mo/day/yr sample was submitted

Water Well Disinfected? Yes No

5 TYPE OF BLANK CASING USED:	5 Wrought iron	8 Concrete tile	CASING JOINTS: Glued <input checked="" type="checkbox"/> Clamped
------------------------------	----------------	-----------------	--

Blank casing diameter 5 in. to 240 ft., Dia in. to ft., Dia in. to ft.

Casing height above land surface 24 in., weight 3.706 lbs./ft. Wall thickness or gauge No. SDR 21.316

TYPE OF SCREEN OR PERFORATION MATERIAL:	7 PVC	10 Asbestos-Cement
1 Steel	8 RMP (SR)	11 Other (Specify)
2 Brass	9 ABS	12 None used (open hole)
3 Stainless Steel		
4 Galvanized Steel		
5 Fiberglass		
6 Concrete tile		

SCREEN OR PERFORATION OPENINGS ARE:

1 Continuous slot	3 Mill slot	5 Gauzed wrapped	8 Saw cut	11 None (open hole)
2 Louvered shutter	4 Key punched	6 Wire wrapped	9 Drilled holes	
		7 Torch cut	10 Other (specify)	

SCREEN-PERFORATED INTERVALS: From 240 ft. to 260 ft., From ft. to ft.

GRAVEL PACK INTERVALS: From 60 ft. to 260 ft., From ft. to ft.

6 GROUT MATERIAL:	<input checked="" type="radio"/> 1 Neat cement	2 Cement grout	3 Bentonite	<input checked="" type="radio"/> 4 Other <u>Hole Plug</u>
-------------------	--	----------------	-------------	---

Grout Intervals: From 1 ft. to 25 ft., From ft. to ft., From ft. to ft.

What is the nearest source of possible contamination:

1 Septic tank	4 Lateral lines	7 Pit privy	10 Livestock pens	14 Abandoned water well
2 Sewer lines	5 Cess pool	8 Sewage lagoon	11 Fuel storage	15 Oil well/Gas well
3 Watertight sewer lines	6 Seepage pit	9 Feedyard	12 Fertilizer storage	16 Other (specify below)
			13 Insecticide storage	

Direction from well? How many feet?

FROM	TO	LITHOLOGIC LOG	FROM	TO	PLUGGING INTERVALS
0	2	Surface			
2	8	Sandy clay			
8	104	Clay and sandy clay			
104	121	Sand			
121	136	Clay			
136	156	Sand			
156	204	Clay			
204	259	Sand			
259	260	Clay			

7 CONTRACTOR'S OR LANDOWNER'S CERTIFICATION: This water well was <input checked="" type="radio"/> (1) constructed, (2) reconstructed, or (3) plugged under my jurisdiction and was completed on (mo/day/year) <u>6-5-05</u> and this record is true to the best of my knowledge and belief. Kansas Water Well Contractor's Licence No <u>KWWCL-430</u> This Water Well Record was completed on (mo/day/yr) <u>6-5-05</u> under the business name of <u>Howard Drilling Co BOX 806 Beaver Ok 73932</u> by (signature) <u>[Signature]</u>

INSTRUCTIONS: Use typewriter or ball point pen. PLEASE PRESS FIRMLY and PRINT clearly. Please fill in blanks, underline or circle the correct answers. Send two copies to Kansas Department of Health and Environment, Bureau of Water, Geology Section, 1000 SW Jackson St., Suite 420, Topeka, Kansas 66612-1367. Telephone 785-296-5522. Send one to WATER WELL OWNER and retain one for your records. Fee of \$5.00 for each constructed well.