


1 LOCATION OF WATER WELL: Fraction N 1/2 1/4 SE 1/4 SW 1/4 Section Number 9 Township Number T 34 S Range Number R 32 EW  
 County: Seward

Distance and direction from nearest town or city street address of well if located within city?  
 From Hayne, KS: 1/4 N and W into--

2 WATER WELL OWNER: Beredco, Inc.  
 RR#, St. Address, Box # : 401 E Douglas Board of Agriculture, Division of Water Resources  
 City, State, ZIP Code : Wichita, KS 67202 Application Number: T 88-129

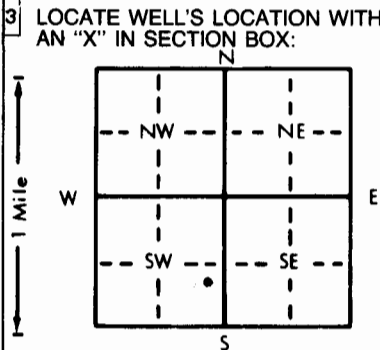

4 DEPTH OF COMPLETED WELL: 280 ft. ELEVATION: ...  
 Depth(s) Groundwater Encountered 1. 192 ft. 2. ... ft. 3. ... ft.  
 WELL'S STATIC WATER LEVEL ... 192 ft. below land surface measured on mo/day/yr ... 3-4-88  
 Pump test data: Well water was ... 197 ft. after ... 1 hours pumping ... 80 gpm  
 Est. Yield ... 80 gpm: Well water was ... ft. after ... hours pumping ... gpm  
 Bore Hole Diameter ... 9 1/2 in. to ... 280 ft., and ... in. to ... ft.  
 WELL WATER TO BE USED AS: 5 Public water supply 8 Air conditioning 11 Injection well  
 1 Domestic 3 Feedlot 6 Oil field water supply 9 Dewatering 12 Other (Specify below)  
 2 Irrigation 4 Industrial 7 Lawn and garden only 10 Observation well  
 Was a chemical/bacteriological sample submitted to Department? Yes... No... X...; If yes, mo/day/yr sample was submitted  
 Water Well Disinfected? Yes X No

5 TYPE OF BLANK CASING USED: 5 Wrought iron 8 Concrete tile CASING JOINTS: Glued X Clamped  
 1 Steel 3 RMP (SR) 6 Asbestos-Cement 9 Other (specify below) Welded  
 2 PVC 4 ABS 7 Fiberglass Threaded  
 Blank casing diameter ... 5 1/2 in. to ... 280 ft., Dia ... in. to ... ft., Dia ... in. to ... ft.  
 Casing height above land surface ... 24 in., weight ... lbs./ft. Wall thickness or gauge No. ... 0.032  
 TYPE OF SCREEN OR PERFORATION MATERIAL: 7 PVC 10 Asbestos-cement  
 1 Steel 3 Stainless steel 5 Fiberglass 8 RMP (SR) 11 Other (specify)  
 2 Brass 4 Galvanized steel 6 Concrete tile 9 ABS 12 None used (open hole)  
 SCREEN OR PERFORATION OPENINGS ARE: 5 Gauzed wrapped 8 Saw cut 11 None (open hole)  
 1 Continuous slot 3 Mill slot 6 Wire wrapped 9 Drilled holes  
 2 Louvered shutter 4 Key punched 7 Torch cut 10 Other (specify)  
 SCREEN-PERFORATED INTERVALS: From ... 220 ft. to ... 280 ft., From ... ft. to ... ft.  
 GRAVEL PACK INTERVALS: From ... 120 ft. to ... 280 ft., From ... ft. to ... ft.

6 GROUT MATERIAL: 1 Neat cement X 2 Cement grout 3 Bentonite 4 Other dirt  
 Grout Intervals: From ... 1 ft. to ... 20 ft., From ... ft. to ... ft., From ... ft. to ... ft.  
 What is the nearest source of possible contamination:  
 1 Septic tank 4 Lateral lines 7 Pit privy 10 Livestock pens 14 Abandoned water well  
 2 Sewer lines 5 Cess pool 8 Sewage lagoon 11 Fuel storage 15 Oil well/Gas well  
 3 Watertight sewer lines 6 Seepage pit 9 Feedyard 12 Fertilizer storage 16 Other (specify below)  
 13 Insecticide storage  
 Direction from well? Southwest How many feet? 100

FROM	TO	LITHOLOGIC LOG	FROM	TO	LITHOLOGIC LOG
0	11	Sandy Clay			
11	90	Clay			
90	110	Sandy Clay			
110	275	Sand			
275	280	Clay			

7 CONTRACTOR'S OR LANDOWNER'S CERTIFICATION: This water well was (1) constructed, (2) reconstructed, or (3) plugged under my jurisdiction and was completed on (mo/day/year) ... 3-4-88 ... and this record is true to the best of my knowledge and belief. Kansas Water Well Contractor's License No. ... KWWCL-430 ... This Water Well Record was completed on (mo/day/yr) ... 3-4-88 ... under the business name of Howard Drlg. Co. Box 806 Beaver, OK 73932 by (signature) *Howard Drlg. Co.*

INSTRUCTIONS: Use typewriter or ball point pen, PLEASE PRESS FIRMLY and PRINT clearly. Please fill in blanks, underline or circle the correct answers. Send top three copies to Kansas Department of Health and Environment, Division of Environment, Environmental Geology Section, Topeka, KS 66620. Send one to WATER WELL OWNER and retain one for your records.