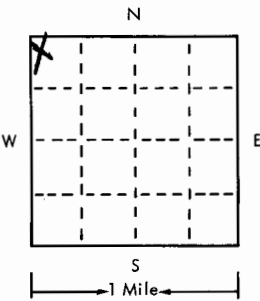


USE TYPEWRITER OR BALL POINT PEN-PRESS FIRMLY, PRINT CLEARLY.

T R EW sec 1/4 1/4 1/4 No.

WATER WELL RECORD
KSA 82a-1201-1215

Kansas State Dept. Of Health
(Water Well Contractors)
Forbes-Bldg. 740
Topeka, Kansas 66620

1 Location of well:	County Seward	Township name	Fraction 10 1/4 1/4 1/4	Section number 10	Town number 34	Range number 32
Distance and direction from nearest town or city: 68 1/2 mi of Liberal, Ka				8 Owner of well: Ed Pittman Address: Box 592 L15 EXRL		
Locate with "X" in section below: 				Sketch map:		
2 Type and color of material				From	To	4 Well depth: 382 ft. Date of completion 2/24/76 Well diameter 2 1/2 in.
Overburden				0	2	5 <input type="checkbox"/> Cable tool <input checked="" type="checkbox"/> Rotary <input type="checkbox"/> Driven <input type="checkbox"/> Dug <input type="checkbox"/> Hollow rod <input type="checkbox"/> Jetted <input type="checkbox"/> Bored <input type="checkbox"/> Reverse rotary
Top Soil				2	180	6 Use: <input type="checkbox"/> Domestic <input type="checkbox"/> Public supply <input type="checkbox"/> Industry <input checked="" type="checkbox"/> Irrigation <input type="checkbox"/> Air conditioning <input type="checkbox"/> Commercial <input type="checkbox"/> Test well <input type="checkbox"/>
Coarse Sd. & Gravel & Clay Strks.				180	250	7 Casing: Material Steel Height: above/below Threading <input type="checkbox"/> Welded <input checked="" type="checkbox"/> Surface 1 1/2 in. Diam. 1 1/2 in. to 382 ft. depth Drive shoe? <input type="checkbox"/> Yes <input checked="" type="checkbox"/> No 1 1/2 in. to 382 ft. depth
Coarse Sd. & Clay				250	280	8 Screen: Manufacturer L.B. Foster Type Steel Dia. 1 1/2 " Slot/gauze 1/8 Length 13 Set between 182 ft. and 350 ft. Fittings: 370 382 1/2 to 1/4 Gravel pack <input checked="" type="checkbox"/> Yes <input type="checkbox"/> No Size range of material _____
Gravel & Clay				280	320	9 Static water level: 178 ft. below land surface Date 2/24/76
Yellow Clay & Coarse Sd.				320	350	10 Pumping level below land surfaces: NA ____ ft. after ____ hrs. pumping ____ g.p.m. ____ ft. after ____ hrs. pumping ____ g.p.m. Estimated maximum yield ____ g.p.m.
Coarse Sd.				350	384	11 Water sample submitted: <input type="checkbox"/> Yes <input checked="" type="checkbox"/> No Date _____
						12 Well head completion: <input type="checkbox"/> Pitless adapter NA <input type="checkbox"/> Inches above grade
						13 Well grouted? <input checked="" type="checkbox"/> Yes <input type="checkbox"/> No <input checked="" type="checkbox"/> Neat cement <input type="checkbox"/> Bentonite <input type="checkbox"/> Depth: From 0 ft. to 10 ft.
						14 Nearest source of possible contamination: ft. _____ Direction _____ Type _____ Well disinfected upon completion? <input type="checkbox"/> Yes <input checked="" type="checkbox"/> No
						15 Pump: <input type="checkbox"/> Not installed Manufacturer's name _____ Model number _____ HP _____ Volts _____ Length of drop pipe _____ ft. capacity _____ g.p.m. Type: Pump Set By Third Party <input type="checkbox"/> Submersible <input type="checkbox"/> Turbine <input type="checkbox"/> Jet <input type="checkbox"/> Reciprocating <input type="checkbox"/> Centrifugal <input type="checkbox"/> Other
16 Remarks: elevation				17 Water well contractor's certification: This well was drilled under my jurisdiction and this report is true to the best of my knowledge and belief. KIM DRILLING, INC. 225 Business name _____ License No. _____ Address: Box 1385, Guymon, OK 74541 Signed: Ray Nelson Date 3/21/76 Authorized representative		
Topography: <input type="checkbox"/> Hill <input type="checkbox"/> Slope <input checked="" type="checkbox"/> Upland <input type="checkbox"/> Valley						

34 32 W 10 NW NW NW