USE TYPEWRITER OR BALL POINT PEN-PRESS FIRMLY, PRINT CLEARLY.

WATER WELL RECORD
KSA 82a-1201-1215

Kansas Department of Health and Environment-Division of Environment
(Water well Contractors)
Topeka, Kansas 66620

CWW Inv. 15784

1. Location of well:	County	Fraction	Section number	Township number	Range number
	Seward	/1/4 /1/4 SE/4	34	T 34 S	R 32 E/W

2. Distance and direction from nearest town or city: From Liberal go 7 miles east on blacktop turn left to location
Street address of well location if in city:

3. Owner of well: Dr. H.C. Palmer, Jr.
R.R. or street: 1229 Terrace
City, state, zip code: Liberal, Kans. 67901

4. Locate with "X" in section below: Sketch map:

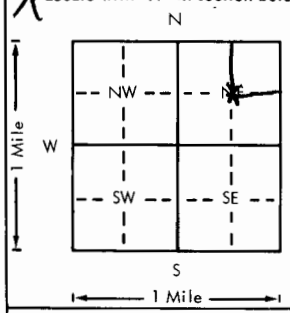

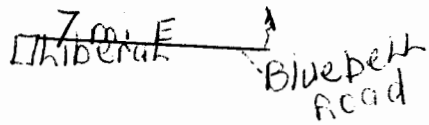

6. Bore hole dia. 9 in. Completion date 4-27-79
Well depth 280 ft.

7. __ Cable tool X Rotary __ Driven __ Dug
__ Hollow rod __ Jetted __ Bored __ Reverse rotary

8. Use: X Domestic __ Public supply __ Industry
__ Irrigation __ Air conditioning __ Stock
__ Lawn __ Oil field water __ Other

9. Casing: Material ____ Height: Above or below
Threaded ____ Welded ____ Surface 28 in.
RMP ____ PVC X Weight 2.78 lbs./ft.
Dia. 5 in. to 210 ft. depth Wall Thickness: inches or
Dia. ____ in. to ____ ft. depth gage No. 265

10. Screen: Manufacturer's name Sawed perf.
Type PVC Dia. 5"
Slot/gauze .030 Length 70'
Set between 210 ft. and 280 ft.
____ ft. and ____ ft.
Gravel pack? Yes Size range of material ____

11. Static water level: mo./day/yr.
173 ft. below land surface Date 4-27-79

12. Pumping level below land surfaces:
____ ft. after ____ hrs. pumping ____ g.p.m.
____ ft. after ____ hrs. pumping ____ g.p.m.
Estimated maximum yield 45 g.p.m.

13. Water sample submitted: mo./day/yr.
__ Yes X No Date ____

14. Well head completion:
__ Pitless adapter 28 Inches above grade

15. Well grouted? Yes
With: X Neat cement ____ Bentonite ____ Concrete
Depth: From 0 ft. to 10 ft.

16. Nearest source of possible contamination:
ft. ____ Direction ____ Type None
Well disinfected upon completion? X Yes ____ No

17. Pump: X Not installed
Manufacturer's name ____
Model number ____ HP ____ Volts ____
Length of drop pipe ____ ft. capacity ____ g.p.m.
Type:
__ Submersible __ Turbine
__ Jet __ Reciprocating
__ Centrifugal __ Other

5. Type and color of material	From	To
Surface	0	2
Clay	2	72
Gravel	72	78
Clay	78	95
Medium to large sand 80% & Gravel 20%	95	165
Clay 15% &medium to large sand 85%	165	182
Fine sand	182	280

(Use a second sheet if needed)

18. Elevation:

Topography:
__ Hill
__ Slope
X Upland
__ Valley

19. Remarks:

20. Water well contractor's certification:
This well was drilled under my jurisdiction and this report is true to the best of my knowledge and belief. 118
Carlile Water Well Service
Business name License No.
Address Box AA Liberal, Ks. 67901
Signed Edward E. Mears Date 5-29-79
Authorized representative

T 34 S R 32 E Sec 34 1/4 1/4 1/4 SE

Forward the white, blue and pink copies to the Department of Health and Environment

Form WWC-5

M1-1023