

**CORRECTION(S) TO WATER WELL RECORD (Form WWC-5)**  
 (to rectify lacking or incorrect information)

<b>LOCATION OF WATER WELL:</b> County: _____	Fraction _____ 1/4 _____ 1/4 _____ 1/4 _____ 1/4	Section _____	Township T _____ S	Range R _____ <input type="checkbox"/> E <input type="checkbox"/> W
---	---	------------------	-----------------------	--

**Owner:** \_\_\_\_\_

**Location was listed as:**

Sec. \_\_\_\_\_ T \_\_\_\_\_ S R \_\_\_\_\_ E W

Fraction: \_\_\_\_\_

**Location changed to:**

Sec. \_\_\_\_\_ T \_\_\_\_\_ S R \_\_\_\_\_ E W

Fraction: \_\_\_\_\_

**Other changes:** Initial statements: \_\_\_\_\_

Changed to: \_\_\_\_\_

Comments: \_\_\_\_\_

Verification method: \_\_\_\_\_

\_\_\_\_\_ initials: \_\_\_\_\_ date: \_\_\_\_\_


Submitted by: Kansas Geological Survey, Data Resources Library, 1930 Constant Ave., Lawrence, KS 66047-3726  
 to: Kansas Dept of Health & Environment, Bureau of Water, 1000 SW Jackson, Suite 420, Topeka, KS 66612-1367.

WATER WELL RECORD Form WWC-5 KSA 82a-1212

1 LOCATION OF WATER WELL: County: Seward Fraction: SE 1/4 SE 1/4 NE 1/4 Section Number: 33 Township Number: T 34 S Range Number: R 33 E (W)

Distance and direction from nearest town or city street address of well if located within city?

2 WATER WELL OWNER: RR#, St. Address, Box #: U-Pump It 1001 N. Ks Ave Liberal, Ks 67901 City, State, ZIP Code: Liberal, Ks 67901 MW# 17 Board of Agriculture, Division of Water Resources Application Number:

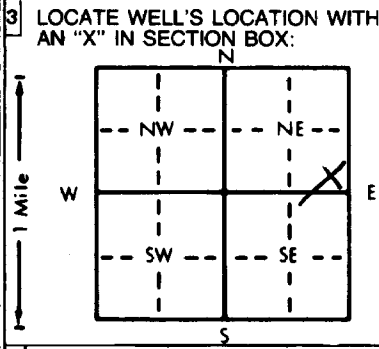

4 DEPTH OF COMPLETED WELL: 170 ft. ELEVATION: 143.03 ft. below land surface measured on mo/day/yr






WELL WATER TO BE USED AS: 5 Public water supply 8 Air conditioning 11 Injection well  
 1 Domestic 3 Feedlot 6 Oil field water supply 9 Dewatering 12 Other (Specify below)  
 2 Irrigation 4 Industrial 7 Lawn and garden only 10 Monitoring well

Was a chemical/bacteriological sample submitted to Department? Yes ..... No .....x.....; If yes, mo/day/yr sample was submitted

Water Well Disinfected? Yes ..... No .....x.....

5 TYPE OF BLANK CASING USED: 1 Steel 3 RMP (SR) 5 Wrought iron 8 Concrete tile CASING JOINTS: Glued ..... Clamped .....  
 2 PVC 4 ABS 6 Asbestos-Cement 9 Other (specify below) Welded .....  
 7 Fiberglass ..... Threaded .....x.....

Blank casing diameter 4 in. to 140 ft., Dia ..... in. to ..... ft., Dia ..... in. to ..... ft.

Casing height above land surface 0 in., weight 2.071 lbs./ft. Wall thickness or gauge No. 237

TYPE OF SCREEN OR PERFORATION MATERIAL: 1 Steel 3 Stainless steel 5 Fiberglass 8 RMP (SR) 10 Asbestos-cement  
 2 Brass 4 Galvanized steel 6 Concrete tile 9 ABS 11 Other (specify) .....  
 12 None used (open hole)

SCREEN OR PERFORATION OPENINGS ARE: 1 Continuous slot 3 Mill slot 5 Gauzed wrapped 8 Saw cut 11 None (open hole)  
 2 Louvered shutter 4 Key punched 6 Wire wrapped 9 Drilled holes  
 7 Torch cut 10 Other (specify) .....

SCREEN-PERFORATED INTERVALS: From .....140..... ft. to .....170..... ft., From ..... ft. to ..... ft.  
 From ..... ft. to ..... ft., From ..... ft. to ..... ft.

GRAVEL PACK INTERVALS: From .....138..... ft. to .....170..... ft., From ..... ft. to ..... ft.  
 From ..... ft. to ..... ft., From ..... ft. to ..... ft.

6 GROUT MATERIAL: 1 Neat cement 2 Cement grout 3 Bentonite 4 Other .....

Grout Intervals: From .....0..... ft. to .....134..... ft., From .....134..... ft. to .....138..... ft., From ..... ft. to ..... ft.

What is the nearest source of possible contamination: 1 Septic tank 4 Lateral lines 7 Pit privy 10 Livestock pens 14 Abandoned water well  
 2 Sewer lines 5 Cess pool 8 Sewage lagoon 11 Fuel storage 15 Oil well/Gas well  
 3 Watertight sewer lines 6 Seepage pit 9 Feedyard 12 Fertilizer storage 16 Other (specify below)  
 13 Insecticide storage Contaminated Site .....

Direction from well? How many feet?

FROM	TO	LITHOLOGIC LOG	FROM	TO	PLUGGING INTERVALS
0	.6	Cement			
.6	8	Louess			
8	20	Clay & caliche			
20	32	Sugar sand w/clay			
32	50	Clay & caliche			
55	63	Caliche & clay w/some sandstone			
63	68	Sugar sand w/clay			
68	71	Caliche & clay			
71	80	Sugar sand w/clay & sandstone strks			
80	88	Caliche & sandy clay w/some sand stone			
88	93	Sugar sand w/clay			
93	100	Fine to med sand w/clay			
100	154	Sandy clay w/caliche w/a few sand strks			
154	159	Gravel caliche & clay hard			
159	170	Sandy clay caliche & cemented sand fairly hard			

7 CONTRACTOR'S OR LANDOWNER'S CERTIFICATION: This water well was (1) constructed, (2) reconstructed, or (3) plugged under my jurisdiction and was completed on (mo/day/year) 3-22-99 and this record is true to the best of my knowledge and belief. Kansas Water Well Contractor's License No. 554 This Water Well Record was completed on (mo/day/yr) 3-30-99 under the business name of Woofter Pump & Well Inc. by (signature) Jerry G. Woofter

INSTRUCTIONS: Use typewriter or ball point pen. PLEASE PRESS FIRMLY and PRINT clearly. Please fill in blanks, underline or circle the correct answers. Send top three copies to Kansas Department of Health and Environment, Bureau of Water, Topeka, Kansas 66620-0001. Telephone: 913-296-5545. Send one to WATER WELL OWNER and retain one for your records.