

CORRECTION(S) TO WATER WELL RECORD (Form WWC-5)
(to rectify lacking or incorrect information)

LOCATION OF WATER WELL: County: _____	Fraction _____ 1/4 _____ 1/4 _____ 1/4 _____ 1/4	Section _____	Township T _____ S	Range R _____ <input type="checkbox"/> E <input type="checkbox"/> W
---	---	------------------	-----------------------	--

Owner: _____

Location was listed as:

Sec. _____ T _____ S R _____ E W

Fraction: _____

Location changed to:

Sec. _____ T _____ S R _____ E W

Fraction: _____

Other changes: Initial statements: _____

Changed to: _____

Comments: _____

Verification method: _____

_____ initials: _____ date: _____


Submitted by: Kansas Geological Survey, Data Resources Library, 1930 Constant Ave., Lawrence, KS 66047-3726
to: Kansas Dept of Health & Environment, Bureau of Water, 1000 SW Jackson, Suite 420, Topeka, KS 66612-1367.

WATER WELL RECORD Form WWC-5 KSA 82a-1212

1 LOCATION OF WATER WELL: County: Seward Fraction: SW 1/4 SW 1/4 NW 1/4 Section Number: 33 Township Number: T 34 S Range Number: R 33 E/W

Distance and direction from nearest town or city street address of well if located within city?

2 WATER WELL OWNER: U-Pump It
 RR#, St. Address, Box #: 1001 N. Kansas Ave
 City, State, ZIP Code: Liberal, Ks 67901
 Board of Agriculture, Division of Water Resources
 MW # 18 Application Number:

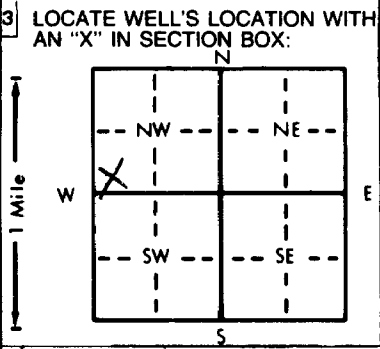

4 DEPTH OF COMPLETED WELL: 169 ft. ELEVATION: _____ ft.
 Depth(s) Groundwater Encountered: 1 ft. 2 ft. 3 ft. _____ ft.
 WELL'S STATIC WATER LEVEL: 144.30 ft. below land surface measured on mo/day/yr _____ ft.
 Pump test data: Well water was _____ ft. after _____ hours pumping _____ gpm
 Est. Yield _____ gpm: Well water was _____ ft. after _____ hours pumping _____ gpm
 Bore Hole Diameter: .8 in. to 169 ft., and _____ in. to _____ ft.
 WELL WATER TO BE USED AS:
 5 Public water supply 8 Air conditioning 11 Injection well
 1 Domestic 3 Feedlot 6 Oil field water supply 9 Dewatering 12 Other (Specify below)
 2 Irrigation 4 Industrial 7 Lawn and garden only 10 Monitoring well _____
 Was a chemical/bacteriological sample submitted to Department? Yes _____ No X; If yes, mo/day/yr sample was submitted _____
 Water Well Disinfected? Yes _____ No X

5 TYPE OF BLANK CASING USED:
 1 Steel 3 RMP (SR) 5 Wrought iron 8 Concrete tile CASING JOINTS: Glued _____ Clamped _____
 2 PVC 4 ABS 6 Asbestos-Cement 9 Other (specify below) Welded _____
 7 Fiberglass _____ Threaded. xxx
 Blank casing diameter: 4 in. to 140 ft., Dia _____ in. to _____ ft., Dia _____ in. to _____ ft.
 Casing height above land surface: 0 in., weight 2.071 lbs./ft. Wall thickness or gauge No. 237
 TYPE OF SCREEN OR PERFORATION MATERIAL:
 1 Steel 3 Stainless steel 5 Fiberglass 7 PVC 10 Asbestos-cement
 2 Brass 4 Galvanized steel 6 Concrete tile 8 RMP (SR) 11 Other (specify) _____
 9 ABS 12 None used (open hole)
 SCREEN OR PERFORATION OPENINGS ARE:
 1 Continuous slot 3 Mill slot 5 Gauzed wrapped 8 Saw cut 11 None (open hole)
 2 Louvered shutter 4 Key punched 6 Wire wrapped 9 Drilled holes
 7 Torch cut 10 Other (specify) _____
 SCREEN-PERFORATED INTERVALS: From 140 ft. to 170 ft., From _____ ft. to _____ ft.
 From _____ ft. to _____ ft., From _____ ft. to _____ ft.
 GRAVEL PACK INTERVALS: From 138 ft. to 170 ft., From _____ ft. to _____ ft.
 From _____ ft. to _____ ft., From _____ ft. to _____ ft.

6 GROUT MATERIAL: 1 Neat cement 2 Cement grout 3 Bentonite 4 Other _____
 Grout intervals: From 0 ft. to 134 ft., From 134 ft. to 170 ft., From _____ ft. to _____ ft.
 What is the nearest source of possible contamination:
 1 Septic tank 4 Lateral lines 7 Pit privy 10 Livestock pens 14 Abandoned water well
 2 Sewer lines 5 Cess pool 8 Sewage lagoon 11 Fuel storage 15 Oil well/Gas well
 3 Watertight sewer lines 6 Seepage pit 9 Feedyard 12 Fertilizer storage 16 Other (specify below)
 13 Insecticide storage Contaminated Site
 Direction from well? _____
 How many feet? _____

FROM	TO	LITHOLOGIC LOG	FROM	TO	PLUGGING INTERVALS
0	.6	Cement	104.5	107	Fine sand w/clay
.6	8	Louess	107	118	Clay & caliche tight
8	14	Clay	118	124	Sandy clay w/some fine sand
14	20	Sandy clay w/fine sand	124	155	Clay & caliche hard
20	31	Sugar to fine sand w/clay	155	158	Fine sand
31	43	Tight sandy clay w/caliche	158	162	Hard cemented sand sandstone clay
43	45	Sandy clay w/sand	162	169	Sandy clay & caliche
45	53	Sugar to fine, sand w/clay layers fairly loose			
53	55	Tight clay w/caliche			
55	71	Tight sandy clay w/caliche			
71	79	Sugar to fine sand w/clay			
79	87	Tight sandy clay & caliche			
87	100	Sandy clay caliche w/sand stone			
100	102	Med sand & gravel			
102	104.5	Caliche clay & some cemented sand hard			

7 CONTRACTOR'S OR LANDOWNER'S CERTIFICATION: This water well was (1) constructed, (2) reconstructed, or (3) plugged under my jurisdiction and was completed on (mo/day/year) 3-23-99 and this record is true to the best of my knowledge and belief. Kansas Water Well Contractor's License No. 554 This Water Well Record was completed on (mo/day/yr) 3-30-99 under the business name of Woofter Pump & Well Inc. by (signature) [Signature]

INSTRUCTIONS: Use typewriter or ball point pen. PLEASE PRESS FIRMLY and PRINT clearly. Please fill in blanks, underline or circle the correct answers. Send top three copies to Kansas Department of Health and Environment, Bureau of Water, Topeka, Kansas 66620-0001. Telephone: 913-296-5545. Send one to WATER WELL OWNER and retain one for your records.