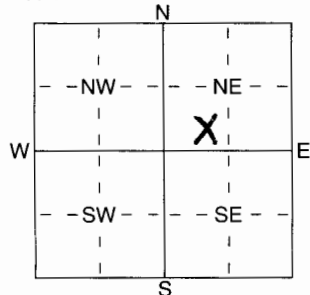


1	LOCATION OF WATER WELL:	Fraction	Section Number	Township Number	Range Number
County:	<i>Seward</i>	<i>SE 1/4 SW 1/4 NW 1/4</i>	<i>29</i>	T <i>345</i> S	R <i>33</i> E/W

Distance and direction from nearest town or city street address of well if located within city?
5' N of house @ 2111 Tulip GPS 37°3.746'N 100° 55.639'W

2	WATER WELL OWNER:	RR#, St. Address, Box #	City, State, ZIP Code	Board of Agriculture, Division of Water Resources
	<i>David R. Beaver</i>	<i>2111 Tulip</i>	<i>Liberal, KS 67901</i>	Application Number:

3	LOCATE WELL'S LOCATION WITH AN "X" IN SECTION BOX:	4	DEPTH OF COMPLETED WELL	ELEVATION:
		<i>200</i>	<i>289.2</i>	

Depth(s) Groundwater Encountered 1 ft. 2 ft. 3 ft.
 WELL'S STATIC WATER LEVEL ft. below land surface measured on mo/day/yr
 Pump test data: Well water was ft. after hours pumping gpm
 Est. Yield gpm: Well water was ft. after hours pumping gpm
 WELL WATER TO BE USED AS: 5 Public water supply 8 Air conditioning 11 Injection well
 1 Domestic 3 Feedlot 6 Oil field water supply 9 Dewatering 12 Other (Specify below)
 2 Irrigation 4 Industrial 7 Domestic (lawn & garden) 10 Monitoring well
closed loop
 Was a chemical/bacteriological sample submitted to Department? Yes No X; If yes, mo/day/yr sample was submitted
 Water Well Disinfected? Yes No

5	TYPE OF BLANK CASING USED:	5 Wrought iron	8 Concrete tile	CASING JOINTS: Glued Clamped
	1 Steel 3 RMP (SR)	6 Asbestos-Cement	9 Other (specify below)	Welded
	2 PVC 4 ABS	7 Fiberglass		Threaded

Blank casing diameter in. to ft., Dia in. to ft., Dia in. to ft.
 Casing height above land surface in., weight lbs./ft. Wall thickness or gauge No.
 TYPE OF SCREEN OR PERFORATION MATERIAL:
 1 Steel 3 Stainless Steel 5 Fiberglass 7 PVC 10 Asbestos-Cement
 2 Brass 4 Galvanized Steel 6 Concrete tile 8 RMP (SR) 11 Other (Specify)
 9 ABS 12 None used (open hole)
 SCREEN OR PERFORATION OPENINGS ARE:
 1 Continuous slot 3 Mill slot 5 Gauzed wrapped 8 Saw cut 11 None (open hole)
 2 Louvered shutter 4 Key punched 6 Wire wrapped 9 Drilled holes
 7 Torch cut 10 Other (specify) ft.

SCREEN-PERFORATED INTERVALS: From ft. to ft., From ft. to ft.
 From ft. to ft., From ft. to ft.
 GRAVEL PACK INTERVALS: From ft. to ft., From ft. to ft.
 From ft. to ft., From ft. to ft.

6	GROUT MATERIAL:	1 Neat cement	2 Cement grout	3 Bentonite	4 Other
---	-----------------	---------------	----------------	-------------	---------------

Grout intervals: From ft. to ft., From ft. to ft., From ft. to ft.
 What is the nearest source of possible contamination:
 1 Septic tank 4 Lateral lines 7 Pit privy 10 Livestock pens 14 Abandoned water well
 2 Sewer lines 5 Cess pool 8 Sewage lagoon 11 Fuel storage 15 Oil well/Gas well
3 Watertight sewer lines 6 Seepage pit 9 Feedyard 12 Fertilizer storage 16 Other (specify below)
 13 Insecticide storage
 Direction from well? *SE* How many feet? *30*

FROM	TO	LITHOLOGIC LOG	FROM	TO	PLUGGING INTERVALS
<i>0</i>	<i>80</i>	<i>sand w/ clay</i>	<i>200</i>	<i>0</i>	<i>high solids bentonite</i>
<i>80</i>	<i>90</i>	<i>sandstone</i>			<i>11.6 #/gal.</i>
<i>90</i>	<i>170</i>	<i>sand w/ clay</i>			
<i>170</i>	<i>200</i>	<i>clay</i>			

7	CONTRACTOR'S OR LANDOWNER'S CERTIFICATION: This water well was <u>(1) constructed</u> , (2) reconstructed, or (3) plugged under my jurisdiction and was completed on (mo/day/year) <i>9-2-07</i> and this record is true to the best of my knowledge and belief. Kansas Water Well Contractor's Licence No <i>733</i> This Water Well Record was completed on (mo/day/yr) <i>9-12-07</i> under the business name of <i>C+C Loop Drilling</i> by (signature) <i>Ken Campbell</i>
---	--