


WATER WELL RECORD Form WWC-5 KSA 82a-1212

1 LOCATION OF WATER WELL: Fraction *Center of S 1/2* Section Number 05 Township Number T 34 S Range Number R 33 W
 COUNTY: 088 SEWARD

Distance and direction from nearest town or city street address of well if located within city?
 FROM LIBERAL; APPX 3 1/4 MILES NORTH

2 WATER WELL OWNER: J.W. FITZGERALD Board of Agriculture, Division of Water Resources
 RR#, St. Address, Box #: RR 2 Application Number: 45,344
 City, State, ZIP code: LIBERAL, KS 67901-

3 LOCATE WELL'S LOCATION WITH AN "X" IN SECTION BOX:

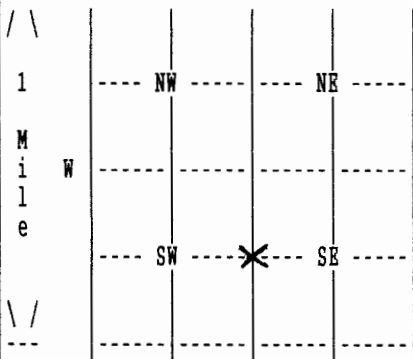

4 DEPTH OF COMPLETED WELL 615 ELEVATION: 0
 Depth(s) Groundwater Encountered 1. 0 ft. 2. 0 ft. 3. 0 ft.

WELL'S STATIC WATER LEVEL 196 ft. below land surface measured on mo/day/yr 11/09/04
 Pump test data: Well water was 540 ft. after 4 hours pumping 400 gpm

Estimated Yield 0 gpm: Well water was 0 ft. after 0 hours pumping 0 gpm

Bore Hole Diameter 24 in. to 615 ft., and in. to 0 ft.

WELL WATER TO BE USED AS: 02 IRRIGATION

Was a chemical/bacteriological sample submitted to department? No;
 If yes, mo/day/yr sample was submitted Water well disinfected? Yes

5 TYPE OF BLANK CASING USED: 01 STEEL CASING JOINTS: WELDED
 Blank casing diameter 16 in. to 615 ft., Dia in. to 0 ft., Dia in. to 0 ft.
 Casing height above land surface 12 in., weight 42 lbs/ft. Wall thickness or gauge No. .250
 TYPE OF SCREEN OR PERFORATION MATERIAL: 01 STEEL
 SCREEN OR PERFORATION OPENINGS ARE: 01 CONT. SLOT

SCREEN PERFORATED INTERVALS: From 310 ft. to 310 ft., From 0 ft. to 0 ft.
 From 0 ft. to 0 ft., From 0 ft. to 0 ft.
 GRAVEL PACK INTERVALS: From 20 ft. to 615 ft., From 0 ft. to 0 ft.
 From 0 ft. to 0 ft., From 0 ft. to 0 ft.

6 GROUT MATERIAL 03 BENTONITE
 Grout Intervals: From 0 ft. to 20 ft., From 0 ft. to 0 ft., From 0 ft. to 0 ft.
 What is the nearest source of possible contamination: NONE OBSERVED
 Direction from well? How many feet? 0

FROM	TO	LITHOLOGIC LOG	FROM	TO	PLUGGING INTERVALS
0	2	02 SILT			
2	23	04 SANDY CLAY			
23	62	07 FINE SAND 04 SANDY CLAY			
62	73	05 SAND			
73	94	04 SANDY CLAY			
94	102	05 SAND 15 CRS GRAVEL			
102	157	04 SANDY CLAY			
157	195	05 SAND 01 CLAY			
195	220	05 SAND			
220	392	05 SAND			

7 CONTRACTOR'S OR LANDOWNER'S CERTIFICATION: This water well was Constructed under my jurisdiction and was completed on (mo/day/year) 11/03/04 and this record is true to the best of my knowledge and belief. Kansas Water Well Contractor's License No. 145 This Water Well Record was completed on (mo/day/yr) 12/23/04 under the business name of HENKLE DRILLING & SUPPLY by (signature)

(Continued)

WATER WELL RECORD Form WWC-5 KSA 82a-1212

1 LOCATION OF WATER WELL: COUNTY: 088 SEWARD	Fraction 1/4	1/4 S 1 2 1/4	Section Number 05	Township Number T 34 S	Range Number R 33 W
---	-----------------	---------------	----------------------	---------------------------	------------------------

2 WATER WELL OWNER: RR#, St. Address, Box # : RR 2 City, State, ZIP code : LIBERAL, KS 67901-	J.W. FITZGERALD Board of Agriculture, Division of Water Resources Application Number: 45,344
---	--

FROM	TO	LITHOLOGIC LOG
392	562	07 FINE SAND 08 MEDIUM SAND 01 CLAY
562	603	07 FINE SAND 01 CLAY
603	610	04 SANDY CLAY
610	622	19 SHALE

7 CONTRACTOR'S OR LANDOWNER'S CERTIFICATION: This water well was Constructed under my jurisdiction and was completed on (mo/day/year) 11/03/04 and this record is true to the best of my knowledge and belief. Kansas Water Well Contractor's License No. 145 This Water Well Record was completed on (mo/day/yr) 12/23/04 under the business name of HENKLE DRILLING & SUPPLY by (signature) *Bern J. Reichert*