

CORRECTION(S) TO WATER WELL RECORD (WWC-5)

(to rectify lacking or incorrect information)

County: Seward

Location listed as:

Section-Township-Range: _____

Fraction ($\frac{1}{4}$ $\frac{1}{4}$ $\frac{1}{4}$): _____

Location ~~changed to:~~

24-345-33W

NW SW NW

Other changes: Initial statements: Clark County

Changed to: Seward County

Comments: _____

verification method: Written & legal descriptions, and mapping tool on KGS website.

initials: WRL date: 6/5/2007

submitted by: Kansas Geological Survey, Data Resources Library, 1930 Constant Ave., Lawrence, KS 66047-3726
to: Kansas Dept of Health & Environment, Bureau of Water, 1000 SW Jackson, Suite 420, Topeka, KS 66612-1367.


1 LOCATION OF WATER WELL: | Fraction | Section Number | Township Number | Range Number
 COUNTY: 013 CLARK | NW 1/4 SW 1/4 NW 1/4 | 24 | T 34 S | R 33 W

Distance and direction from nearest town or city street address of well if located within city?

From Liberal; Approx 2 miles north & 2 miles east

2 WATER WELL OWNER: NATIONAL BEEF PACKING CO
 RR#, St. Address, Box # : PO BOX 978 Board of Agriculture, Division of Water Resources
 City, State, ZIP code : LIBERAL, LS 67901- Application Number:

3 LOCATE WELL'S LOCATION WITH AN "X" IN SECTION BOX: | 4 DEPTH OF COMPLETED WELL 640 ELEVATION: 0
 Depth(s) Groundwater Encountered 1. 0 ft. 2. 0 ft. 3. 0 ft.

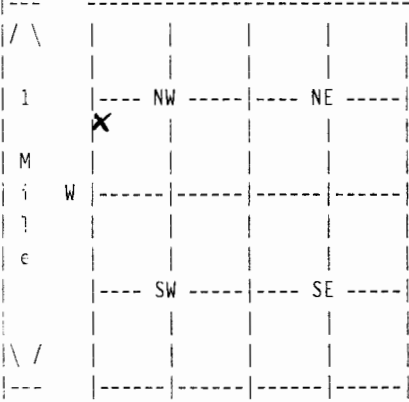

WELL'S STATIC WATER LEVEL 206ft. below land surface measured on mo/day/yr 08/23/06
 Pump testdata: Well water was 0 ft. after 0 hours pumping 0 gpm
 Estimated Yield 0 gpm: Well water was 0 ft. after 0 hours pumping 0 gpm
 Bore Hole Diameter 12 1/4 in. to 0 ft., and in. to 0 ft.
 WELL WATER WAS: 10 Monitoring
 Was a chemical/bacteriological sample submitted to department? No ;
 If yes, mo/day/yr sample was submitted Water well disinfected? Yes

5 TYPE OF BLANK CASING USED: 02 PVC CASING JOINTS: OTHER - CERTILOK
 Blank casing diameter 5 in. to 640 ft., Dia in. to 0 ft., Dia in. to 0 ft.
 Casing height above land surface -48 in., weight 4 lbs/ft. Wall thickness or gauge No. .327
 TYPE OF SCREEN OR PERFORATION MATERIAL: 07 PVC
 SCREEN OR PERFORATION OPENINGS ARE: 03 MILL SLOT

SCREEN PERFORATED INTERVALS: From 300 ft. to 320 ft., From 420 ft. to 440 ft.
 From 380 ft. to 400 ft., From 460 ft. to 480 ft.
 GRAVEL PACK INTERVALS: From 208 ft. to 640 ft., From 0 ft. to 0 ft.
 From 0 ft. to 0 ft., From 0 ft. to 0 ft.

6 GROUT MATERIAL 03 BENTONITE
 Grout Intervals: From 0 ft. to 208 ft., From 0 ft. to 0 ft., From 0 ft. to 0 ft.
 What is the nearest source of possible contamination: NONE OBSERVED
 Direction from well? How many feet? 0

FROM	TO	LITHOLOGIC LOG	FROM	TO	PLUGGING INTERVALS
			0	3	TOP SOIL
			3	206	BENTONITE
			206	640	GRAVEL
			0	0	
			0	0	
			0	0	
			0	0	
			0	0	
			0	0	
			0	0	

7 CONTRACTOR'S OR LANDOWNER'S CERTIFICATION: This water well was Plugged under my jurisdiction and was completed on (mo/day/year) 02/26/07 and this record is true to the best of my knowledge and belief. Kansas Water Well Contractor's License No. 145 This Water Well Record was completed on (mo/day/yr) 04/25/07 under the business name of HENKLE DRILLING & SUPPLY by (signature) *Bruce Reichert*