


1	LOCATION OF WATER WELL:	Fraction	Section Number	Township Number	Range Number
County:	<u>Seward</u>	<u>SW 1/4 SW 1/4 SW 1/4</u>	<u>34</u>	<u>34 S</u>	<u>33</u>

Distance and direction from nearest town or city street address of well if located within city?
721 E Pancake Blvd Liberal KS

2	WATER WELL OWNER:	Board of Agriculture, Division of Water Resources
RR #, St. Address, Box #:	<u>Fred Frye</u>	Application Number:
City, State, ZIP Code :	<u>125 CR 136-C Kingsland TX 78639</u>	

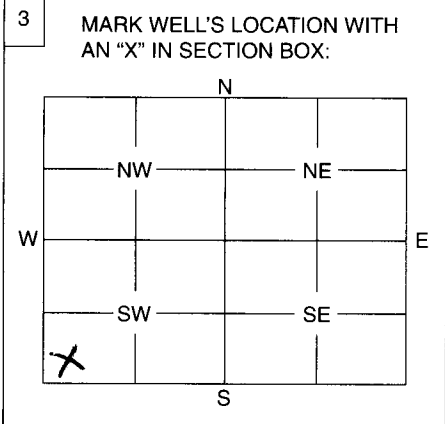

4	DEPTH OF WELL	<u>175</u> ft.
	WELL'S STATIC WATER LEVEL	<u>164.8</u> ft.
WELL WAS USED AS:		
1 Domestic	5 Public Water Supply	9 Dewatering
2 Irrigation	6 Oil Field Water Supply	<u>10 Monitoring Well</u>
3 Feedlot	7 Domestic (Lawn & Garden)	11 Injection Well
4 Industrial	8 Air Conditioning	12 Other
Was a chemical / bacteriological sample submitted to Department? Yes No <u>✓</u>		
If yes, mo/day/yr sample was submitted		
Water Well Disinfected: Yes No <u>✓</u>		

5	TYPE OF BLANK CASING USED:			
1 Steel	3 RMP (SR)	5 Wrought	7 Fiberglass	9 Other (Specify below)
<u>2 PVC</u>	4 ABS	6 Asbestos-Cement	8 Concrete Tile	
Blank casing diameter	<u>4</u> in.	Was casing pulled?	Yes No <u>✓</u>	If yes, how much
Casing height above or below land surface	<u>0.5 ft.</u>			

6	GROUT PLUG MATERIAL:	1 Neat cement	2 Cement grout	<u>3 Bentonite</u>	4 Other
Grout Plug Intervals:	From <u>175</u> ft. to <u>0.5</u> ft.,	Fromft. toft.,	Fromft. toft.,	From to ft.	
What is the nearest source of possible contamination:					
1 Septic tank	6 Seepage pit	<u>11 Fuel storage</u>	16 Other (specify below)		
2 Sewer lines	7 Pit privy	12 Fertilizer storage			
3 Watertight sewer lines	8 Sewage lagoon	13 Insecticide storage			
4 Lateral lines	9 Feedyard	14 Abandoned water well			
5 Cess pool	10 Livestock pens	15 Oil well/Gas well			
Direction from well?	<u>SW</u>	How many feet?	<u>550'</u>		

FROM	TO	PLUGGING MATERIALS
<u>175</u>	<u>0.5'</u>	<u>Bentonite</u>

7	CONTRACTOR'S OF LANDOWNER'S CERTIFICATION: This water well was plugged under my jurisdiction and was completed on (mo/day/year) <u>6/3/07</u> and this record is true to the best of my knowledge and belief. Kansas Water Well Contractor's License No. <u>615127</u> This Water Well Record was completed on (mo/day/year) <u>6/5/07</u> under the business name of <u>Sedate Co</u> by (signature) <u>[Signature]</u>
---	--

INSTRUCTIONS: Use typewriter or ball point pen. Please press firmly and print clearly. Please fill in blanks, underline or circle the correct answers. Send top three copies to Kansas Department of Health and Environment, Bureau of Water, Geology Section, 1000 SW Jackson St., Ste. 420, Topeka, Kansas 66612-1367. Telephone: 785/296-5522. Send one to Water Well Owner and retain one for your records.