


1 LOCATION OF WATER WELL: Fraction **NW 1/4 SW 1/4 SW 1/4** Section Number **33** Township Number **T 34 S** Range Number **R 33w EW**
 County: **Seward**

Distance and direction from nearest town or city street address of well if located within city?
Kansas Avenue and 10th St Liberal, KS

2 WATER WELL OWNER: **Former Quality Laundry and Cleaners**
 RR#, St. Address, Box # : **907 N Kansas Ave** Board of Agriculture, Division of Water Resources
 City, State, ZIP Code : **Liberal, KS 67901** Application Number:

3 LOCATE WELL'S LOCATION WITH AN "X" IN SECTION BOX:

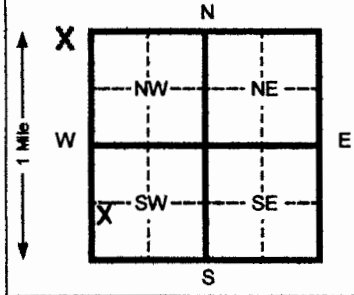

4 DEPTH OF COMPLETED WELL **200** ft. ELEVATION:
 Depth(s) Groundwater Encountered 1 _____ ft. 2 _____ ft. 3 _____ ft.
 WELL'S STATIC WATER LEVEL **161.04** ft. below land surface measured on mo/day/yr
 Pump test data: Well water was _____ ft. after _____ hours pumping _____ gpm
 Est. Yield _____ gpm: Well water was _____ ft. after _____ hours pumping _____ gpm
 Bore Hole Diameter **8** in. to **205** ft. and _____ in. to _____ ft.
 WELL WATER TO BE USED AS:
 1 Domestic 2 Irrigation 3 Feed lot 4 Industrial 5 Public water supply 6 Oil field water supply 7 Lawn and garden (domestic) 8 Air conditioning 9 Dewatering 10 Monitoring well 11 Injection well 12 Other (Specify below)
 Was a chemical/bacteriological sample submitted to Department? Yes _____ No **X** If yes, mo/day/yr sample was submitted _____
 Water Well Disinfected? Yes _____ No **X**

5 TYPE OF BLANK CASING USED:
 1 Steel 2 **PVC** 3 RMP (SR) 4 ABS 5 Wrought Iron 6 Asbestos-Cement 7 Fiberglass 8 Concrete tile 9 Other (specify below) CASING JOINTS: Glued _____ Clamped _____ Welded _____ Threaded **X**
 Blank casing diameter **4** in. to **170** ft., Dia _____ in. to _____ ft., Dia _____ in. to _____ ft.
 Casing height above land surface **0** in., weight **2.071** lbs./ft. Wall thickness or gauge No. **237**
 TYPE OF SCREEN OR PERFORATION MATERIAL:
 1 Steel 2 Brass 3 Stainless steel 4 Galvanized steel 5 Fiberglass 6 Concrete tile 7 **PVC** 8 RMP (SR) 9 ABS 10 Asbestos-cement 11 Other (specify) 12 None used (open hole)
 SCREEN OR PERFORATION OPENINGS ARE:
 1 Continuous slot 2 Louvered shutter 3 Mill slot 4 Key punched 5 Gauzed wrapped 6 Wire wrapped 7 Torch cut 8 **Saw cut** 9 Drilled holes 10 Other (specify) 11 None (open hole)
 SCREEN-PERFORATED INTERVALS: From **170** ft. to **200** ft. From _____ ft. to _____ ft.
 GRAVEL PACK INTERVALS: From **167** ft. to **200** ft. From _____ ft. to _____ ft.

6 GROUT MATERIAL: 1 Neat cement 2 **Cement grout** 3 Bentonite 4 Other
 Grout intervals From **0** ft. to **164** ft. From **164** ft. to **167** ft. From _____ ft. to _____ ft.
 What is the nearest source of possible contamination:
 1 Septic tank 2 Sewer lines 3 Watertight sewer lines 4 Lateral lines 5 Cess pool 6 Seepage pit 7 Pit privy 8 Sewage lagoon 9 Feedyard 10 Livestock pens 11 Fuel storage 12 Insecticide storage 14 Abandoned water well 15 Oil well/ Gas well 16 Other (specify below) **CONTAMINATED SITE**
 Direction from well? _____ How many feet? _____

FROM	TO	CODE	LITHOLOGIC LOG	FROM	TO	PLUGGING INTERVALS
0	2		Surface			Strks
2	18		Clay w/caliche strks & sd lenses	105	113	Clay w/sand clay strks & cal. Lenses
18	30		Fine sand w/caliche lenses	113	132	Sandy clay w/clay strks & caliche
30	41		Clay & caliche w/fine sd strks			Lenses
41	50		Sandy clay w/caliche lenses	132	150	Caliche w/clay strks
50	55		Caliche	150	155	Caliche w/sand strks
55	65		Clay w/caliche strks & sandy	155	158	Fine to med sand
			Clay	158	181	Caliche w/sand strks
65	75		Caliche w/sandy clay & clay strk	181	205	Fine to med sd w/clay & caliche
75	85		Sandy clay w/caliche strks &			lenses
			Clay lenses			
85	90		Caliche w/sand, clay strks			
90	97		Fine sand w/caliche strks			
97	105		Fine to some med sd w/caliche			

7 CONTRACTOR'S OR LANDOWNER'S CERTIFICATION: This water well was (1) constructed, (2) reconstructed, or (3) plugged under my jurisdiction and was completed on (mo/day/yr) **9-11-07** and this record is true to the best of my knowledge and belief. Kansas Water Well Contractor's License No. **554** This Water Well Record was completed on (mo/day/yr) **09-20-07** under the business name of **Woofor Pump & Well Inc.** by (signature) *[Signature]*

OFFICE USE ONLY

T

R

SEC