

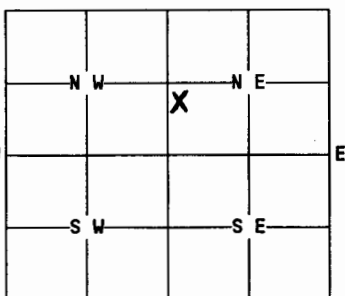
1	LOCATION OF WATER WELL: County: SEWARD	Fraction NW 1/4 NW 1/4 SE 1/4	Section Number 31	Township Number 34	Range Number 33W
---	---	----------------------------------	----------------------	-----------------------	---------------------

Distance and direction from nearest town or city street address of well if located within city?
 Located at Willow Creek Golf Course next to the pond. 1110 Industrial Park Road

2 WATER WELL OWNER: CITY OF LIBERAL

RR#, St. Address, Box #: PO BOX 2199
 City, State, ZIP Code: LIBERAL KS 67905-2199

Board of Agriculture, Division of Water Resources
 Application Number: 33048

3	MARK WELL'S LOCATION WITH AN "X" IN SECTION BOX: N  S	4	DEPTH OF WELL.....480.....ft. WELL'S STATIC WATER LEVEL.....175.....ft. WELL WAS USED AS: 1 Domestic 2 Irrigation 3 Feedlot 4 Industrial 5 Public Water Supply 6 Oil Field Water Supply 7 Lawn and Garden Only 8 Air Conditioning 9 Dewatering 10 Monitoring Well 11 Injection Well 12 Other..... Was a chemical/bacteriological sample submitted to Department? Yes <input checked="" type="checkbox"/> No..... If yes, mo/day/yr sample was submitted..... Water Well Disinfected: Yes <input checked="" type="checkbox"/> No.....
---	---	---	---

5 TYPE OF BLANK CASING USED:

1 Steel 3 RMP (SR) 5 Wrought 7 Fiberglass 9 Other (specify below)
 2 PVC 4 ABS 6 Asbestos-Cement 8 Concrete Tile

Blank casing diameter...16.....in. Was casing pulled? Yes..... No If yes, how much.....
 Casing height above or below land surface.....36...in.

6 GROUT PLUG MATERIAL: 1 Neat cement 2 Cement grout 3 Bentonite 4 Other.....

Grout Plug Intervals: From..12.ft. to..36.ft., From..138.ft. to..145.ft., From..... to.....ft.

What is the nearest source of possible contamination:

1 Septic tank 6 Seepage pit 11 Fuel storage 16 Other (specify below) Grey water holding pond for Golf Course Irrigation
 2 Sewer lines 7 Pit privy 12 Fertilizer storage
 3 Watertight sewer lines 8 Sewage lagoon 13 Insecticide storage
 4 Lateral lines 9 Feedyard 14 Abandoned water well
 5 Cess Pool 10 Livestock pens 15 Oil well/Gas well

Direction from well? ...East..... How many feet? ...112 ft.....

FROM	TO	PLUGGING MATERIALS
0	12'	Fill Dirt
12'	36'	Sodium Bentonite
36'	138'	Sand
138'	168'	Sodium Bentonite
168'	480'	Sand & Gravel Mix

7 CONTRACTOR'S OR LANDOWNER'S CERTIFICATION: This water well was plugged under my jurisdiction and was completed on (mo/day/year) August 8, 1998. and this record is true to the best of my knowledge and belief. Kansas Water Well Contractor's License No. This Water Well Record was completed on (mo/day/year) August 14, 1998. under the business name of City of Liberal
 by (signature) *Kevin Lemo*

INSTRUCTIONS: Use typewriter or ball point pen. Please press firmly and print clearly. Please fill in blanks, underline or circle the correct answers. Send top three copies to Kansas Department of Health and Environment, Bureau of Water, Topeka, Kansas 66620-0001. Telephone: 913/296-3565. Send one to Water Well Owner and retain one for your records.