

CORRECTION(S) TO WATER WELL RECORD (WWC-5)
(to rectify lacking or incorrect information)

County: Seward

Location listed as:

Location changed to:

Section-Township-Range: 25-34-33

25-34S-33W

Fraction (1/4 1/4 1/4): NE

E2 NE NE

Other changes: Initial statements: No county given.

Changed to: Seward County

Comments:

verification method: written & legal descriptions, position on plat map, and mapping tool & aerial photos on KGS website.


initials: ARL date: 7/17/2012

submitted by: Kansas Geological Survey, Data Resources Library, 1930 Constant Ave., Lawrence, KS 66047-3726
to: Kansas Dept of Health & Environment, Bureau of Water, 1000 SW Jackson, Suite 420, Topeka, KS 66612-1367.

1 LOCATION OF WATER WELL: County: NE 1/4 25-34-33	Fraction 1/4 1/4 1/4	Section Number NE 1/4 25	Township 34	Range 33	Number E/W
---	-------------------------	------------------------------------	-----------------------	--------------------	---------------

Distance and direction from nearest town or city street address of well if located within city?
3 mile East of 54-83 Hwy Intersection & 1 mile East on Tucker Road & 1/4 South oil oil well site

2 WATER WELL OWNER: R. Gary Warden RR #, St. Address, Box #: 12780 Road 2 (Seward Co) City, State, ZIP Code: Liberal, Ks 67901	Board of Agriculture, Division of Water Resources Application Number:
---	--

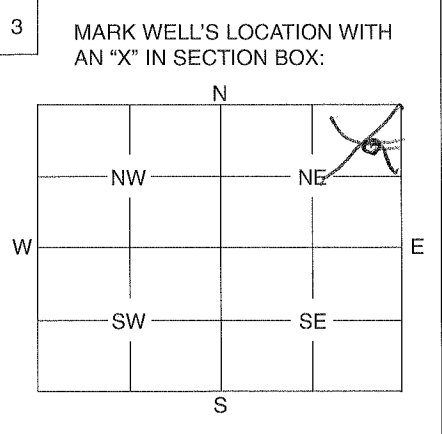

4 DEPTH OF WELL **approx 190'** ft.
 WELL'S STATIC WATER LEVEL **0 None** ft.
 WELL WAS USED AS:

<input checked="" type="radio"/> 1 Domestic	5 Public Water Supply	9 Dewatering
2 Irrigation	6 Oil Field Water Supply	10 Monitoring Well
3 Feedlot	7 Domestic (Lawn & Garden)	11 Injection Well
4 Industrial	8 Air Conditioning	12 Other

Was a chemical / bacteriological sample submitted to Department? Yes No
 If yes, mo/day/yr sample was submitted

Water Well Disinfected: Yes No

5 TYPE OF BLANK CASING USED:

1 Steel	3 RMP (SR)	5 Wrought	7 Fiberglass	9 Other (Specify below)
<input checked="" type="radio"/> 2 PVC	4 ABS	6 Asbestos-Cement	8 Concrete Tile	

Blank casing diameter **5"** in. Was casing pulled? Yes No If yes, how much

Casing height above or below land surface **4 ft approx** in.

6 GROUT PLUG MATERIAL: 1 Neat cement 2 Cement grout **3 Bentonite** 4 Other

Grout Plug Intervals: From **bottom** ft. to **4 Sacks** ft. From **Pea** ft. to **Gravel** ft. From **approx 4' Cement** to **Top** ft.

What is the nearest source of possible contamination: **of Bentonite**

1 Septic tank	6 Seepage pit	11 Fuel storage	16 Other (specify below)
2 Sewer lines	7 Pit privy	12 Fertilizer storage	
3 Watertight sewer lines	8 Sewage lagoon	13 Insecticide storage	
4 Lateral lines	9 Feedyard	14 Abandoned water well	
5 Cess pool	10 Livestock pens	15 Oil well/Gas well	

Direction from well? **East** How many feet? **300ft approx Abandoned**

FROM	TO	PLUGGING MATERIALS
Top of Bentonite	Pea	2 bags to top of casing
		Gravel then approx of Cement - Cap.
		then approx 4' of Area Soil on top

7 CONTRACTOR'S OF LANDOWNER'S CERTIFICATION: This water well was plugged under my jurisdiction and was completed on (mo/day/year) **5/4/12** and this record is true to the best of my knowledge and belief. Kansas Water Well Contractor's License No. _____ This Water Well Record was completed on (mo/day/year) _____ under the business name of _____ by (signature)

INSTRUCTIONS: Use typewriter or ball point pen. Please press firmly and print clearly. Please fill in blanks, underline or circle the correct answers. Send top three copies to Kansas Department of Health and Environment, Bureau of Water, Geology Section, 1000 SW Jackson St., Ste. 420, Topeka, Kansas 66612-1367. Telephone: 785/296-5522. Send one to Water Well Owner and retain one for your records.