

Corrected

WATER WELL RECORD Form WWC-5

Original Record Correction Change in Well Use


Division of Water Resources App. No.

15745

Well ID

1 LOCATION OF WATER WELL: County: Seward Fraction NW 1/4 NW 1/4 NW 1/4 NW 1/4 Section Number 34 Township Number T 34 S Range Number R 33 E W

2 WELL OWNER: Last Name: Business: National Beef Packing Co LLC Address: PO Box 20046 City: Kansas City State: MO ZIP: 64195-0046 Street or Rural Address where well is located: On the East side of Liberal at the employee entrance to National Beef: Go North to the well house, New well location is 85 feet

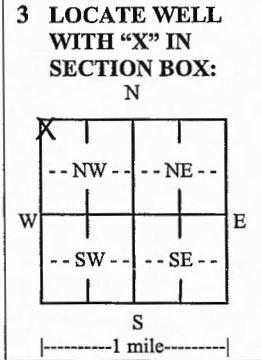

3 LOCATE WELL WITH 'X' IN SECTION BOX: 4 DEPTH OF COMPLETED WELL: 590 ft. Depth(s) Groundwater Encountered: 1) 248 ft. 2) ... ft. 3) ... ft., or 4) Dry Well WELL'S STATIC WATER LEVEL: 248 ft. below land surface, measured on (mo-day-yr) 3/4/2019. Pump test data: Well water was 400 ft. after 4 hours pumping 467 gpm. Estimated Yield: 467 gpm. Bore Hole Diameter: 24 in. to 590 ft. and ... in. to ... ft.

5 Latitude: 37.05331 (decimal degrees) Longitude: 100.90336 (decimal degrees) Datum: WGS 84 NAD 83 NAD 27 Source for Latitude/Longitude: GPS (unit make/model) Land Survey Topographic Map Online Mapper: 6 Elevation: 2824 ft. Ground Level TOC Source: Land Survey GPS Topographic Map Other

7 WELL WATER TO BE USED AS: 1. Domestic: Household Lawn & Garden Livestock 2. Irrigation 3. Feedlot 4. Industrial 5. Public Water Supply: well ID Well # 10 6. Dewatering: how many wells? 7. Aquifer Recharge: well ID 8. Monitoring: well ID 9. Environmental Remediation: well ID Air Sparge Soil Vapor Extraction Recovery Injection 10. Oil Field Water Supply: lease 11. Test Hole: well ID Cased Uncased Geotechnical 12. Geothermal: how many bores? a) Closed Loop Horizontal Vertical b) Open Loop Surface Discharge Inj. of Water 13. Other (specify):

Was a chemical/bacteriological sample submitted to KDHE? Yes No If yes, date sample was submitted: Water well disinfected? Yes No

8 TYPE OF CASING USED: Steel PVC Other CASING JOINTS: Glued Clamped Welded Threaded Casing diameter 16 in. to 590 ft., Diameter in. to ... ft., Diameter in. to ... ft. Casing height above land surface 12 in. Weight 62.64 lbs./ft. Wall thickness or gauge No. 0.375 TYPE OF SCREEN OR PERFORATION MATERIAL: Steel Stainless Steel Fiberglass PVC Other (Specify) Brass Galvanized Steel Concrete tile None used (open hole) SCREEN OR PERFORATION OPENINGS ARE: Continuous Slot Mill Slot Gauze Wrapped Torch Cut Drilled Holes Other (Specify) Louvered Shutter Key Punched Wire Wrapped Saw Cut None (Open Hole) SCREEN-PERFORATED INTERVALS: From 240 ft. to 580 ft., From ... ft. to ... ft., From ... ft. to ... ft. GRAVEL PACK INTERVALS: From 112 ft. to 590 ft., From ... ft. to ... ft., From ... ft. to ... ft.

9 GROUT MATERIAL: Neat cement Cement grout Bentonite Other Grout Intervals: From 0 ft. to 107 ft., From 107 ft. to 112 ft., From ... ft. to ... ft. Nearest source of possible contamination: No potential source of contamination within 200 ft. Septic Tank Lateral Lines Pit Privy Livestock Pens Insecticide Storage Sewer Lines Cess Pool Sewage Lagoon Fuel Storage Abandoned Water Well Watertight Sewer Lines Seepage Pit Feedyard Fertilizer Storage Oil Well/Gas Well Other (Specify) Direction from well? N Distance from well? 85 ft.

Table with 6 columns: 10 FROM, TO, LITHOLOGIC LOG, FROM, TO, LITHO. LOG (cont.) or PLUGGING INTERVALS. Rows show depth intervals and lithology: 0-2 surface, 2-15 brown sandy clay, 15-60 brown clay, 60-185 brown clay, few sands, 185-220 sand fine to med coarse, 220-260 sand fine to small, 260-320 sand fine few thin clays, 320-340 sand fine clay mixed, 340-540 sand fine clay mixed, some blue clay. Notes: Notes: (blank)

11 CONTRACTOR'S OR LANDOWNER'S CERTIFICATION: This water well was constructed, reconstructed, or plugged under my jurisdiction and was completed on (mo-day-year) 2/28/2019 and this record is true to the best of my knowledge and belief. Kansas Water Well Contractor's License No. 145. This Water Well Record was completed on (mo-day-year) 3/21/2019 under the business name of Hydro Resources Mid Continent, Inc.