USE TYPEWRITER OR BALL POINT PEN-PRESS FIRMLY, PRINT CLEARLY.

WATER WELL RECORD
KSA 82a-1201-1215

Kansas Department of Health and Environment-Division of Environment
(Water well Contractors)
Topeka, Kansas 66620

1. Location of well:	County	Fraction	Section number	Township number	Range number
	Seward	C 1/4 SE 1/4 NW 1/4	3	T 34 S	R 33 E/W

2. Distance and direction from nearest town or city: 5 north on Hwy 83
Street address of well location if in city: 1 east, ½ North, ½ East

3. Owner of well: James Yoxall
R.R. or street: 101 West Fourth Street
City, state, zip code: Liberal, Kansas 67901

4. Locate with "X" in section below:

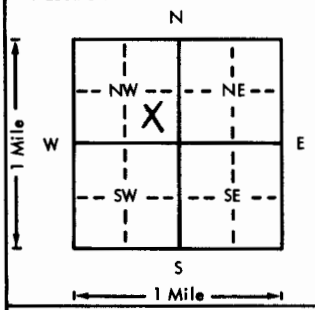

Sketch map:

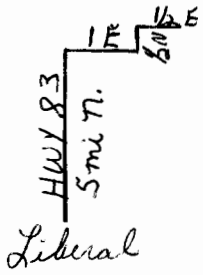

6. Bore hole dia. 10 in. Completion date 5-20-76
Well depth 400 ft.

7. __ Cable tool X Rotary __ Driven __ Dug
__ Hollow rod __ Jetted __ Bored __ Reverse rotary

8. Use: X Domestic __ Public supply __ Industry
__ Irrigation __ Air conditioning __ Stock
__ Lawn __ Oil field water __ Other

9. Casing: Material ____ Height: Above or below
Threaded ____ Welded ____ Surface 28 in.
RMP ____ PVC X Weight 2.78 lbs./ft.
Dia. 5 in. to 400 ft. depth Wall Thickness: inches or
Dia. ____ in. to ____ ft. depth gage No. .265

5. Type and color of material	From	To
Surface	0	2
Fine medium sand	2	120
Fine medium sand-sandy clay 80-20	120	160
Medium to large sand, sandy clay 80-20	160	310
Medium to large sand, sandy clay, blue 60-40	310	340
Fine to medium sand, sandy clay blue 70-30	340	400
(Use a second sheet if needed)		

10. Screen: Manufacturer's name Wesco
Type PVC Dia. 5"
Slot/gauze .030 Length 10
Set between 380 ft. and 390 ft.
____ ft. and ____ ft.
Gravel pack? yes Size range of material 1/8 to 3/16

11. Static water level: 250 ft. below land surface Date 5-20-76 mo./day/yr.

12. Pumping level below land surfaces:
____ ft. after ____ hrs. pumping ____ g.p.m.
____ ft. after ____ hrs. pumping ____ g.p.m.
Estimated maximum yield ____ g.p.m.

13. Water sample submitted: mo./day/yr.
__ Yes X No Date ____

14. Well head completion:
X Pitless adapter ____ 18 Inches above grade

15. Well grouted? yes
With: X Neat cement ____ Bentonite ____ Concrete
Depth: From 3 ft. to 13 ft.

16. Nearest source of possible contamination:
ft. ____ Direction ____ Type None
Well disinfected upon completion? X Yes ____ No

17. Pump: ____ Not installed
Manufacturer's name Sta-Rite
Model number 20P4H2 HP 3 Volts 230
Length of drop pipe 294 ft. capacity 60 g.p.m.
Type:
X Submersible ____ Turbine
____ Jet ____ Reciprocating
____ Centrifugal ____ Other

18. Elevation:

Topography:
____ Hill
____ Slope
____ Upland
____ Valley

19. Remarks:

20. Water well contractor's certification:
This well was drilled under my jurisdiction and this report is true to the best of my knowledge and belief.
Carlile Water Well Serv. 118
Business name License No.
Address Box 275, Liberal, Ks. 67901
Signed Edward E. Means Date ____
Authorized representative

T 34 S R 33 E/W Sec 1/4 1/4 1/4 1/4

Forward the white, blue and pink copies to the Department of Health and Environment

Form WWC-5