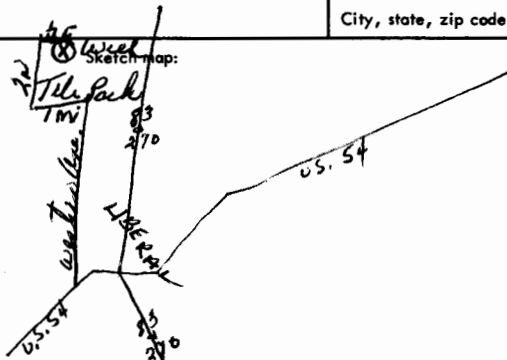


USE TYPEWRITER OR BALL POINT PEN-PRESS FIRMLY, PRINT CLEARLY.

WATER WELL RECORD
KSA 82a-1201-1215

Kansas Department of Health and Environment-Division of Environment
(Water well Contractors)
Topeka, Kansas 66620

1. Location of well:		County Seward	Fraction 1/4 SW 1/4 SW 1/4	Section number 7	Township number T 34 S R 33 E/W	Range number 33
2. Distance and direction from nearest town or city: 1 mile west of Liberal, 2 miles north, 1/4 mile east Street address of well location if in city:			3. Owner of well: Jerry Metcalf R.R. or street: Route #2 City, state, zip code: Liberal, Kansas 67901			
4. Locate with "X" in section below: N W E S 1 Mile 1 Mile			Sketch map: 			6. Bore hole dia. 9 in. Completion date 12-19-75 Well depth 290 ft.
5. Type and color of material			From	To	7. <input type="checkbox"/> Cable tool <input checked="" type="checkbox"/> Rotary <input type="checkbox"/> Driven <input type="checkbox"/> Dug <input type="checkbox"/> Hollow rod <input type="checkbox"/> Jetted <input type="checkbox"/> Bored <input type="checkbox"/> Reverse rotary	
Surface			0	2	8. Use: <input checked="" type="checkbox"/> Domestic <input type="checkbox"/> Public supply <input type="checkbox"/> Industry <input type="checkbox"/> Irrigation <input type="checkbox"/> Air conditioning <input type="checkbox"/> Stock <input type="checkbox"/> Lawn <input type="checkbox"/> Oil field water <input type="checkbox"/> Other	
Sandy clay			2	80	9. Casing: Material _____ Height: Above or below Threaded _____ Welded _____ Surface 28 in. RMP _____ PVC <input checked="" type="checkbox"/> Weight 2.78 lbs./ft. Dia. 5 in. to 250 ft. depth Wall Thickness: _____ inches or Dia. 5 in. to 290 ft. depth gage No. 265	
Medium to large sand			80	100	10. Screen: Manufacturer's name sawed perf. and Wesco Screen Type PVC Dia. 5" Slot/gauze .030 Length 20" perf. 10' screen Set between 250 ft. and 280 ft. _____ ft. and _____ ft. Gravel pack? yes Size range of material 1/8 to 3/16	
Sandy clay			100	180	11. Static water level: _____ mo./day/yr. 135 ft. below land surface Date 12-19-75	
Med. to large sand & Sandy clay 80-20			180	200	12. Pumping level below land surfaces: _____ ft. after _____ hrs. pumping _____ g.p.m. _____ ft. after _____ hrs. pumping _____ g.p.m. Estimated maximum yield _____ 50 _____ g.p.m.	
Med. to large sand & Sandy clay 80-20			200	220	13. Water sample submitted: _____ mo./day/yr. Yes <input checked="" type="checkbox"/> No <input type="checkbox"/> Date _____	
Med. to large sand			220	240	14. Well head completion: <input type="checkbox"/> Pitless adapter 28 inches above grade	
Med. to large sand & sandy clay 80-20			240	260	15. Well grouted? yes With: <input checked="" type="checkbox"/> Neat cement <input type="checkbox"/> Bentonite <input type="checkbox"/> Concrete Depth: From 0 ft. to 10 ft.	
Blue Clay			260	285	16. Nearest source of possible contamination: ft. 250 Direction SW Type Septic Tank Well disinfected upon completion? <input checked="" type="checkbox"/> Yes <input type="checkbox"/> No	
					17. Pump: <input checked="" type="checkbox"/> Not installed Manufacturer's name _____ Model number _____ HP _____ Volts _____ Length of drop pipe _____ ft. capacity _____ g.p.m. Type: <input type="checkbox"/> Submersible <input type="checkbox"/> Turbine <input type="checkbox"/> Jet <input type="checkbox"/> Reciprocating <input type="checkbox"/> Centrifugal <input type="checkbox"/> Other	
					20. Water well contractor's certification: This well was drilled under my jurisdiction and this report is true to the best of my knowledge and belief. Carlile Water Well 118 Business name _____ License No. _____ Address Box 275, Liberal, Ks. Signed Edward E. Means Date 12-22-75 Authorized representative	
18. Elevation:			19. Remarks:			
Topography: <input type="checkbox"/> Hill <input type="checkbox"/> Slope <input checked="" type="checkbox"/> Upland <input type="checkbox"/> Valley						

Forward the white, blue and pink copies to the Department of Health and Environment

Form WWC-5

3
4
3
3
E
-
Z
1/4
1/4
SW
SW