

USE TYPEWRITER OR BALL POINT PEN-PRESS FIRMLY, PRINT CLEARLY.


T R EW sec 1/4 1/4 1/4 No.

WATER WELL RECORD
KSA 82a-1201-1215
1320 FEL
1920 FNL

Kansas State Dept. Of Health
(Water Well Contractors)
Forbes-Bldg. 740
Topeka, Kansas 66620

1 Location of well:	County SEWARD	Township name	Fraction CS 1/2 NE 1/4	Section number 20	Town number 34	Range number 33
---------------------	-------------------------	---------------	----------------------------------	-----------------------------	--------------------------	---------------------------

Distance and direction from nearest town or city: 1 1/2 N. of Liberal, Kansas W. hiway Street address of well location if in city:	3 Owner of well: DaMac Drlg. Co. Address: Box 1164 Great Bend, Kansas
---	--

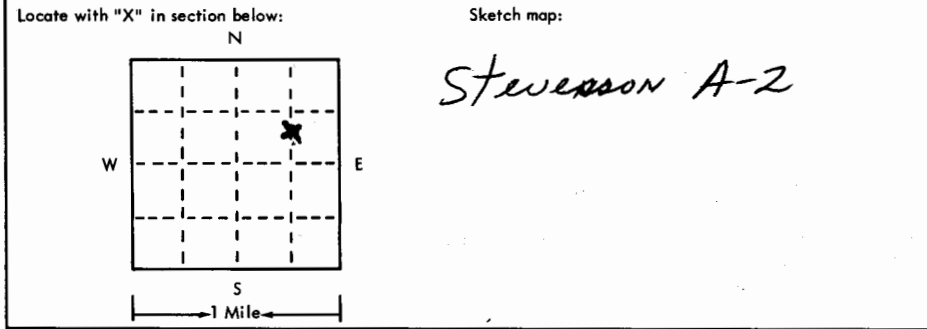

4 Well depth: **260** ft. Date of completion **3-17-75**
Well diameter **9** in.

5 Cable tool Rotary Driven Dug
 Hollow rod Jetted Bored Reverse rotary

6 Use: Domestic Public supply Industry
 Irrigation Air oilfield Commercial
 Test well **oilfield**

7 Casing: Material **pvc** Height: **18** ft. below
 Threaded Welded Surface **18** in.
Dia. **5 1/2**" Weight **200** lbs.
18 in. to **260** depth Drive shoe? Yes No
in. to ft. depth

2 Type and color of material	From	To
SURFACE	0	5
BROWN CLAY	5	70
SMALL SAND	70	125
WHITE CLAY	125	170
CEMENTED SAND	170	185
SMALL TO LARGE GRAVEL	185	260
<i>This H2O Well was turned over to Kenneth Brown, RFD-2, Liberal, KS 67907 by DaMac DRLG Co. by written com. received 5/21/75 5/21/75 DWB</i>		

8 Screen: **none**
Manufacturer _____
Type **200 pvc** Dia. **5 1/2**"
Slot/gauze **hack saw** Length **60**
Set between **200** ft. and **260** ft.
Fittings:
Gravel pack Yes No Size range of material **1/16"**

9 Static water level:
130 ft. below land surface Date **3-17-75**

10 Pumping level below land surfaces:
130 ft. after **1** hrs. pumping **100** g.p.m.
ft. after hrs. pumping g.p.m.
Estimated maximum yield **100** g.p.m.

11 Water sample submitted:
 Yes No Date _____

12 Well head completion: **18"**
 Fittless adapter Inches above grade

13 Well grouted? Yes No
 Neat cement Bentonite
Depth: From **5** ft. to **10** ft.

14 Nearest source of possible contamination:
ft. Direction **neg** Type _____
Well disinfected upon completion? Yes No

15 Pump: Not installed
Manufacturer's name **STA-RITE**
Model number **40P** HP **5 hp** Volts **230V**
Length of drop pipe **220** ft. capacity **100** g.p.m.
Type:
 Submersible Turbine
 Jet Reciprocating
 Centrifugal Other

16 Remarks: elevation

Topography:
 Hill
 Slope
 Upland
 Valley

Pump installed by:
Stricker Pump Service
606 34th Street
Woodward, Okla. 73801

pump & drop pipe disinfected

17 Water well contractor's certification:
This well was drilled under my jurisdiction and this report is true to the best of my knowledge and belief.
Craig Water Well 239
Business name License No.
Address **P.O. Box 521 Woodward, Ok.**
Signed **Craig** Date **3-22-75**
Authorized representative

Forward the white, blue and pink copies to the Kansas State Dept. Of Health.

Form WWC-5

oilfield supply well