

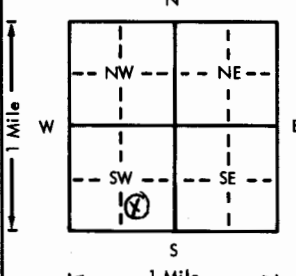
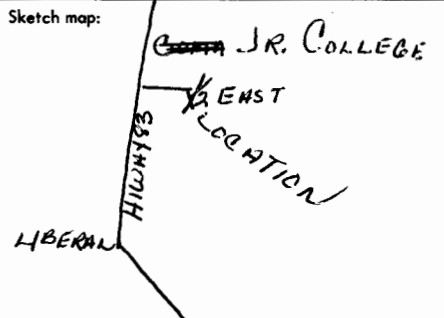
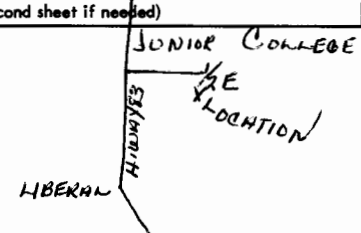
USE TYPEWRITER OR BALL POINT PEN-PRESS FIRMLY, PRINT CLEARLY.

WATER WELL RECORD
KSA 82a-1201-1215

Kansas Department of Health and Environment-Division of Environment
(Water well Contractors)
Topeka, Kansas 66620

W. C. Black Unit G-7

CW Inv. # 11795

1. Location of well: County Seward		Fraction 1/4 SE 1/4 SW 1/4		Section number 28		Township number T 34 S R 33 E/W		Range number			
2. Distance and direction from nearest town or city: 1 mile north and 1/2 east of Liberal Street address of well location if in city:				3. Owner of well: Zennith Drilling Company Rig #2 R.R. or street: Suite 600, 200 W. Douglas City, state, zip code: Wichita, Kansas 67202							
4. Locate with "X" in section below: 				Sketch map: 		6. Bore hole dia. 9 in. Completion date 11-8-75 Well depth 260 ft.		7. <input type="checkbox"/> Cable tool <input checked="" type="checkbox"/> Rotary <input type="checkbox"/> Driven <input type="checkbox"/> Dug <input type="checkbox"/> Hollow rod <input type="checkbox"/> Jetted <input type="checkbox"/> Bored <input type="checkbox"/> Reverse rotary		8. Use: <input type="checkbox"/> Domestic <input type="checkbox"/> Public supply <input type="checkbox"/> Industry <input type="checkbox"/> Irrigation <input type="checkbox"/> Air conditioning <input type="checkbox"/> Stock <input type="checkbox"/> Lawn <input checked="" type="checkbox"/> Oil field water <input type="checkbox"/> Other	
5. Type and color of material				From		To		9. Casing: Material plastic Height: Above or below Threaded <input type="checkbox"/> Welded <input type="checkbox"/> Surface 28 in. RMP <input type="checkbox"/> PVC <input checked="" type="checkbox"/> Weight 2.78 lbs./ft. Dia. 5 in. to 190 ft. depth Wall Thickness: inches or Dia. 5 in. to 260 ft. depth gauge No. .265			
Surface				0		2		10. Screen: Manufacturer's name sawed perf. Type plastic Dia. 5 Slot/gauze .030 Length 80 Set between 190 ft. and 250 ft. _____ ft. and _____ ft. Gravel pack? <input checked="" type="checkbox"/> yes Size range of material 1/8 to 3/16			
Fine sand and caliche				2		40		11. Static water level: 125 ft. below land surface Date 11-8-75 mo./day/yr.			
Sandy clay				40		60		12. Pumping level below land surfaces: _____ ft. after _____ hrs. pumping _____ g.p.m. _____ ft. after _____ hrs. pumping _____ g.p.m. Estimated maximum yield _____ g.p.m.			
Clay and fine sand				60		83		13. Water sample submitted: _____ mo./day/yr. Yes <input checked="" type="checkbox"/> No <input type="checkbox"/> Date _____			
Sandy clay				83		100		14. Well head completion: <input type="checkbox"/> Pitless adapter 28 inches above grade			
Clay and sandy clay				100		137		15. Well grouted? <input checked="" type="checkbox"/> yes With: <input checked="" type="checkbox"/> Neat cement <input type="checkbox"/> Bentonite <input type="checkbox"/> Concrete Depth: From 0 ft. to 10 ft.			
Clay and medium to large sand 70-30				137		160		16. Nearest source of possible contamination: ft. 100 Direction SW Type oilwell Well disinfected upon completion? <input checked="" type="checkbox"/> Yes <input type="checkbox"/> No			
Fine sand and medium to large sand				160		180		17. Pump: <input checked="" type="checkbox"/> Not installed Manufacturer's name _____ Model number _____ HP _____ Volts _____ Length of drop pipe _____ ft. capacity _____ g.p.m. Type: <input type="checkbox"/> Submersible <input type="checkbox"/> Turbine <input type="checkbox"/> Jet <input type="checkbox"/> Reciprocating <input type="checkbox"/> Centrifugal <input type="checkbox"/> Other			
Clay, fine sand and medium to large sand				180		200		20. Water well contractor's certification: This well was drilled under my jurisdiction and this report is true to the best of my knowledge and belief. Carlile Water Well 118 Business name _____ License No. _____ Address Box 275, Liberal, Kansas Signed Edward E. Means Date 11-11-75 Authorized representative			
Fine sand and medium to large sand				200		260		18. Elevation:			
								19. Remarks: 			
								Topography: <input type="checkbox"/> Hill <input type="checkbox"/> Slope <input checked="" type="checkbox"/> Upland <input type="checkbox"/> Valley			

Forward the white, blue and pink copies to the Department of Health and Environment

Form WWC-5