


1 LOCATION OF WATER WELL: Fraction NW 1/4 NW 1/4 NW 1/4 Section Number 20 Township Number T 34 S Range Number R 34 EW

Distance and direction from nearest town or city street address of well if located within city?

2 WATER WELL OWNER: Charles Brecheisen  
 RR#, St. Address, Box # : RR 1 Box 118 Board of Agriculture, Division of Water Resources  
 City, State, ZIP Code : Hugoton KS 67951 Application Number:

3 LOCATE WELL'S LOCATION WITH AN "X" IN SECTION BOX:

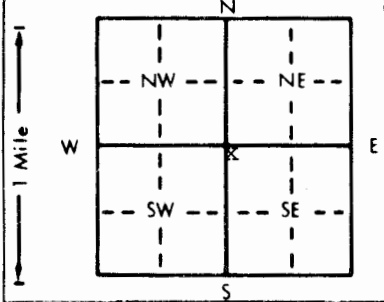

4 DEPTH OF COMPLETED WELL 460 ft. ELEVATION:  
 Depth(s) Groundwater Encountered 1. 214 ft. 2. ft. 3. ft.  
 WELL'S STATIC WATER LEVEL 214 ft. below land surface measured on mo/day/yr 10-10-96  
 Pump test data: Well water was 220 ft. after 70 hours pumping 50 gpm  
 Est. Yield .75 gpm: Well water was ft. after hours pumping gpm  
 Bore Hole Diameter 10 in. to ft. and in. to ft.  
 WELL WATER TO BE USED AS: 5 Public water supply 8 Air conditioning 11 Injection well  
 1 Domestic 3 Feedlot 6 Oil field water supply 9 Dewatering 12 Other (Specify below)  
 2 Irrigation 4 Industrial 7 Lawn and garden only 10 Monitoring well  
 Was a chemical/bacteriological sample submitted to Department? Yes No X; If yes, mo/day/yr sample was submitted  
 Water Well Disinfected? Yes X No

5 TYPE OF BLANK CASING USED:  
 1 Steel 3 RMP (SR) 5 Wrought iron 8 Concrete tile CASING JOINTS: Glued X Clamped  
 2 PVC 4 ABS 6 Asbestos-Cement 9 Other (specify below) Welded  
 7 Fiberglass Threaded  
 Blank casing diameter 5 in. to 400 ft., Dia in. to ft., Dia in. to ft.  
 Casing height above land surface 24 in., weight lbs./ft. Wall thickness or gauge No. sdr26  
 TYPE OF SCREEN OR PERFORATION MATERIAL:  
 1 Steel 3 Stainless steel 5 Fiberglass 8 RMP (SR) 10 Asbestos-cement  
 2 Brass 4 Galvanized steel 6 Concrete tile 9 ABS 11 Other (specify)  
 12 None used (open hole)  
 SCREEN OR PERFORATION OPENINGS ARE:  
 1 Continuous slot 3 Mill slot 5 Gauzed wrapped 8 Saw cut 11 None (open hole)  
 2 Louvered shutter 4 Key punched 6 Wire wrapped 9 Drilled holes  
 7 Torch cut 10 Other (specify)  
 SCREEN-PERFORATED INTERVALS: From 400 ft. to 460 ft., From ft. to ft.  
 GRAVEL PACK INTERVALS: From 25 ft. to 460 ft., From ft. to ft.

6 GROUT MATERIAL: 1 Neat cement 2 Cement grout 3 Bentonite 4 Other  
 Grout Intervals: From 0 ft. to 25 ft., From ft. to ft., From ft. to ft.  
 What is the nearest source of possible contamination:  
 1 Septic tank 4 Lateral lines 7 Pit privy 10 Livestock pens 14 Abandoned water well  
 2 Sewer lines 5 Cess pool 8 Sewage lagoon 11 Fuel storage 15 Oil well/Gas well  
 3 Watertight sewer lines 6 Seepage pit 9 Feedyard 12 Fertilizer storage 16 Other (specify below)  
 13 Insecticide storage  
 Direction from well? NW How many feet? 600

FROM	TO	LITHOLOGIC LOG	FROM	TO	PLUGGING INTERVALS
0	16	Topsoil and clay	311	323	Sand and clay and streaks of little cliche
16	32	Sandy clay			
32	65	Brown sandy clay	328	344	Sand and little clay
65	98	Brown sandy clay and little cliche	344	361	Sand, little clay and little cliche
98	114	Grey clay	361	426	Sand and little clay med to coarse
114	147	Grey clay and little cliche	426	460	Sand medium to coarse
147	164	Brown clay			
164	180	Brown sandy clay and cliche			
180	197	Cliche abn little clay			
197	213	Cliche and sand			
213	229	Sand and little clay			
229	246	Sand and clay			
246	262	Sand			
262	295	Sand and little clay			
295	311	Sandy clay			

7 CONTRACTOR'S OR LANDOWNER'S CERTIFICATION: This water well was (1) constructed, (2) reconstructed, or (3) plugged under my jurisdiction and was completed on (mo/day/year) 10-10-96 and this record is true to the best of my knowledge and belief. Kansas Water Well Contractor's License No. 473 This Water Well Record was completed on (mo/day/yr) 10-10-96 under the business name of Tyler Water Well Service Inc. by (signature) *Pat Z...*