


1 LOCATION OF WATER WELL: **SW** Section Number **33** Township Number **T 34 S** Range Number **R 34 E**
 County: **Seward**
 Distance and direction from nearest town or city street address of well if located within city?
3 1/2 W from Liberal

2 WATER WELL OWNER: **Steve Eisenhower**
 RR#, St. Address, Box # :
 City, State, ZIP Code : **Liberal, KS 67901**
 Board of Agriculture, Division of Water Resources
 Application Number:

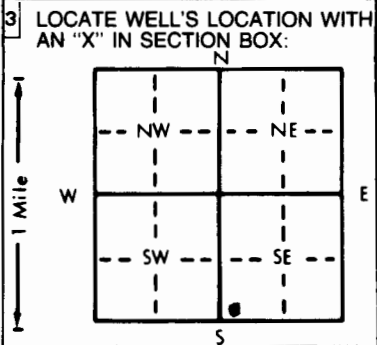

4 DEPTH OF COMPLETED WELL **292** ft. ELEVATION:
 Depth(s) Groundwater Encountered 1. _____ ft. 2. _____ ft. 3. _____ ft.
 WELL'S STATIC WATER LEVEL **130** ft. below land surface measured on mo/day/yr **9-29-98**
 Pump test data: Well water was **172** ft. after **1** hours pumping **20** gpm
 Est. Yield **30** gpm: Well water was _____ ft. after _____ hours pumping _____ gpm
 Bore Hole Diameter **8 3/4** in. to **292** ft. and _____ in. to _____ ft.
 WELL WATER TO BE USED AS:
 Domestic Feedlot Oil field water supply Air conditioning Injection well
 2 Irrigation 4 Industrial 7 Lawn and garden only 9 Dewatering 12 Other (Specify below)
 10 Monitoring well
 Was a chemical/bacteriological sample submitted to Department? Yes _____ No If yes, mo/day/yr sample was submitted
 Water Well Disinfected? Yes No

5 TYPE OF BLANK CASING USED:
 1 Steel 3 RMP (SR) 5 Wrought iron 8 Concrete tile CASING JOINTS: Glued Clamped _____
 PVC 4 ABS 6 Asbestos-Cement 9 Other (specify below) Welded _____
 7 Fiberglass Threaded _____
 Blank casing diameter _____ in. to _____ ft., Dia _____ in. to _____ ft., Dia _____ in. to _____ ft.
 Casing height above land surface **18** in., weight _____ lbs./ft. Wall thickness or gauge No. **200 lb.**
 TYPE OF SCREEN OR PERFORATION MATERIAL:
 1 Steel 3 Stainless steel 5 Fiberglass 8 RMP (SR) 10 Asbestos-cement
 2 Brass 4 Galvanized steel 6 Concrete tile 9 ABS 11 Other (specify) _____
 12 None used (open hole)
 SCREEN OR PERFORATION OPENINGS ARE:
 1 Continuous slot Mill slot 5 Gauzed wrapped 8 Saw cut 11 None (open hole)
 2 Louvered shutter 4 Key punched 6 Wire wrapped 9 Drilled holes
 7 Torch cut 10 Other (specify) _____
 SCREEN-PERFORATED INTERVALS: From **252** ft. to **292** ft., From _____ ft. to _____ ft.
 From _____ ft. to _____ ft., From _____ ft. to _____ ft.
 GRAVEL PACK INTERVALS: From **20** ft. to **292** ft., From _____ ft. to _____ ft.
 From _____ ft. to _____ ft., From _____ ft. to _____ ft.

6 GROUT MATERIAL: 1 Neat cement 2 Cement grout Bentonite 4 Other _____
 Grout Intervals: From **4** ft. to **20** ft., From _____ ft. to _____ ft., From _____ ft. to _____ ft.
 What is the nearest source of possible contamination:
 1 Septic tank Lateral lines 7 Pit privy 10 Livestock pens 14 Abandoned water well
 2 Sewer lines 5 Cess pool 8 Sewage lagoon 11 Fuel storage 15 Oil well/Gas well
 3 Watertight sewer lines 6 Seepage pit 9 Feedyard 12 Fertilizer storage 16 Other (specify below)
 13 Insecticide storage
 Direction from well? **W** How many feet? **150**

FROM	TO	LITHOLOGIC LOG	FROM	TO	PLUGGING INTERVALS
0	5	sandy topsoil			
5	12	sand			
12	26	white clay			
26	45	sand			
45	60	white clay			
60	70	brown clay			
70	100	white clay			
100	120	sand + gravel			
120	190	brown clay			
190	200	sand			
200	210	brown clay			
210	290	sand w/ streaks of clay			

7 CONTRACTOR'S OR LANDOWNER'S CERTIFICATION: This water well was constructed, (2) reconstructed, or (3) plugged under my jurisdiction and was completed on (mo/day/year) **10-5-98** and this record is true to the best of my knowledge and belief. Kansas Water Well Contractor's License No. **101** This Water Well Record was completed on (mo/day/yr) **10-5-98** under the business name of **Bartel Well Drilling, Inc** by (signature) **Reuben J. Bartel**

OFFICE USE ONLY
T
R
E
M
S
E
C.
1/4
1/4
1/4