


1 LOCATION OF WATER WELL: Fraction 01 NE SE
 County: Seward Section Number 34 Township Number 345 Range Number 34W

Distance and direction from nearest town or city street address of well if located within city?
2 Miles West of Liberal

2 WATER WELL OWNER: Nick Hatcher
 RR #, St. Address, Box #: 1108 N Prospect Ave
 City, State, ZIP Code: Liberal, KS 67901 Board of Agriculture, Division of Water Resources
 Application Number: _____

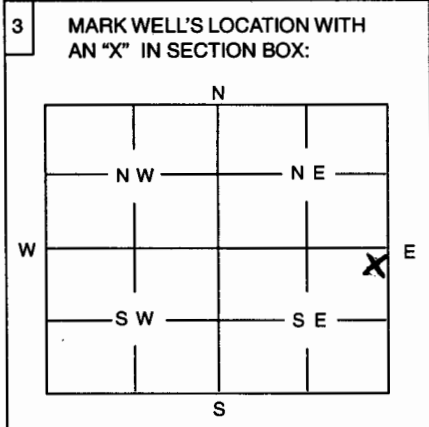

4 DEPTH OF WELL 150 ft
 WELL'S STATIC WATER LEVEL 145 ft.
 WELL WAS USED AS:
 Domestic 5 Public Water Supply 9 Dewatering
 2 Irrigation 6 Oil Field Water Supply 10 Monitoring Well
 3 Feedlot 7 Domestic (Lawn & Garden) 11 Injection Well
 4 Industrial 8 Air Conditioning 12 Other

Was a chemical / bacteriological sample submitted to Department? Yes No X.....
 If yes, mo/day/yr sample was submitted

Water Well Disinfected: Yes X..... No

5 TYPE OF BLANK CASING USED:
 1 Steel 3 RMP (SR) 5 Wrought 7 Fiberglass 9 Other (Specify below)
 2 PVC 4 ABS 6 Asbestos-Cement 8 Concrete Tile

Blank casing diameter 5 in. Was casing pulled? Yes No X..... If yes, how much

Casing height above or below land surface 16 in.

6 GROUT PLUG MATERIAL: 1 Neat cement 2 Cement grout 3 Bentonite 4 Other

Grout Plug Intervals: From ft. to ft., From ft. to ft., From to ft.

What is the nearest source of possible contamination:
 1 Septic tank 6 Seepage pit 11 Fuel storage 16 Other (specify below)
 2 Sewer lines 7 Pit privy 12 Fertilizer storage

3 Watertight sewer lines 8 Sewage lagoon 13 Insecticide storage

4 Lateral lines 9 Feedyard 14 Abandoned water well

5 Cess Pool 10 Livestock pens 15 Oil well/Gas well

Direction from well? East How many feet? 30

FROM	TO	PLUGGING MATERIALS
150	145	chlorinated Sand
145	6	Clay/Subsoil
6	3	Cement
3	-	Cut-off Casing & Backfill

7 CONTRACTOR'S OR LANDOWNER'S CERTIFICATION: This water well was plugged under my jurisdiction and was completed on (mo/day/year) 10-7-05 and this record is true to the best of my knowledge and belief. Kansas Water Well Contractor's License No. 10-8-03 under the business name of Southwest Windmill This Water Well Record was completed on (mo/day/year) by (signature) Daved Emz

INSTRUCTIONS: Use typewriter or ball point pen. Please press firmly and print clearly. Please fill in blanks, underline or circle the correct answers. Send top three copies to Kansas Department of Health and Environment, Bureau of Water, Topeka, Kansas 66620-0001. Telephone: 785/296-3565. Send one to Water Well Owner and retain one for your records.