WATER WELL RECORD Form WWC-5 KSA 62a-1212

1 LOCATION OF WATER WELL: Fraction: NW ¼ NW ¼ NW ¼ | Section Number: 33 | Township Number: T 34 S | Range Number: R 34 E/W

County: Seward

Distance and direction from nearest town or city street address of well if located within city?
6 West & 1 South &1/4 East

2 WATER WELL OWNER:
RR#, St. Address, Box # :
City, State, ZIP Code :

Board of Agriculture, Division of Water Resources
Application Number:

3 LOCATE WELL'S LOCATON WITH AN "X" IN SECTION BOX:

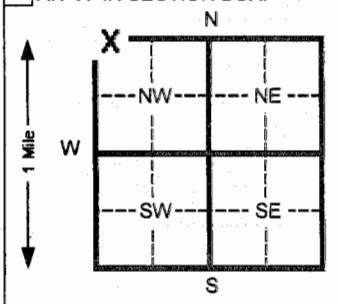

4 DEPTH OF COMPLETED WELL 660 ft. ELEVATION:
Depth(s) Groundwater Encountered 1 210 ft. 2 ft. 3 ft.
WELL'S STATIC WATER LEVEL 210 ft. below land surface measured on mo/day/yr 8/8/05
Pump test data: Well water was ft. after hours pumping gpm
Est. Yield gpm: Well water was ft. after hours pumping gpm
Bore Hole Diameter 26 in. to ft. and in. to ft.
WELL WATER TO BE USED AS: 5 Public water supply 8 Air conditioning 11 Injection well
1 Domestic 3 Feed lot 6 Oil field water supply 9 Dewatering 12 Other (Specify below)
2 Irrigation 4 Industrial 7 Lawn and garden (domestic) 10 Monitoring well
Was a chemical/bacteriological sample submitted to Department? Yes No X If yes, mo/day/yr sample was submitted
Water Well Disinfected? Yes X No

OFFICE USE ONLY
T
R
SEC

5 TYPE OF BLANK CASING USED: 5 Wrought iron 8 Concrete tile CASING JOINTS: Glued Clamped
1 Steel 3 RMP (SR) 6 Asbestos-Cement 9 Other (specify below) Welded
2 PVC 4 ABS 7 Fiberglass Threaded
Blank casing diameter 16 in. to 660 ft., Dia in. to ft., Dia in. to ft.
Casing height above land surface in., weight lbs./ft. Wall thickness or gauge No. .250

TYPE OF SCREEN OR PERFORATION MATERIAL: 7 PVC 10 Asbestos-cement
1 Steel 3 Stainless steel 5 Fiberglass 8 RMP (SR) 11 Other (specify)
2 Brass 4 Galvanized steel 6 Concrete tile 9 ABS 12 None used (open hole)

SCREEN OR PERFORATION OPENINGS ARE: 5 Gauzed wrapped 8 Saw cut 11 None (open hole)
1 Continuous slot 3 Mill slot 6 Wire wrapped 9 Drilled holes
2 Louvered shutter 4 Key punched 7 Torch cut 10 Other (specify)

SCREEN-PERFORATED INTERVALS: From 380 ft. to 420 ft. From 460 ft. to 500 ft.
From 540 ft. to 580 ft. From 620 ft. to 660 ft.
GRAVEL PACK INTERVALS: From 20 ft. to 660 ft. From ft. to ft.
From ft. to ft. From ft. to ft.

6 GROUT MATERIAL: 1 Neat cement 2 Cement grout 3 Bentonite 4 Other
Grout Intervals From 0 ft. to 20 ft. From ft. to ft. From ft. to ft.
What is the nearest source of possible contamination:
1 Septic tank 4 Lateral lines 7 Pit privy 10 Livestock pens 14 Abandoned water well
2 Sewer lines 5 Cess pool 8 Sewage lagoon 11 Fuel storage 15 Oil well/ Gas well
3 Watertight sewer lines 6 Seepage pit 9 Feedyard 12 Fertilizer storage 16 Other (specify below)
13 Insecticide storage None observed
Direction from well? How many feet?

FROM	TO	CODE	LITHOLOGIC LOG	FROM	TO	PLUGGING INTERVALS
0	20		Topsoil & sandy clay	540	650	Fine sand & a little clay
20	40		Fine sand & sandy clay	650	660	Clay & redbed
40	80		Brown sandy clay			
80	100		Fine sand			
100	160		Brown sandy clay			
160	220		Fine to med sand & a little clay			
220	250		Sand, fine to med; sandy clay			
250	255		Red clay			
255	260		Caliche			
260	320		Sandy clay & a little sand			
320	330		Sand, fine			
330	360		Caliche			
360	480		Fine to med sand & a little clay			
480	540		Sand, fine & rock ledges			

7 CONTRACTOR'S OR LANDOWNER'S CERTIFICATION: This water well was (1) constructed, (2) reconstructed, or (3) plugged under my jurisdiction and was completed on (mo/day/yr) 8/05/05 and this record is true to the best of my knowledge and belief. Kansas Water Well Contractor's License No. 473 This Water Well Record was completed on (mo/day/yr) 8/10/05
under the business name of Tyler Water Well Service Inc by (signature)

INSTRUCTIONS:. Please fill in blanks and circle the correct answers. Send three copies to Kansas Department of Health and Environment Bureau of Water, Topeka, Kansas 66620-0001. Telephone: 913-296-5545. Send one to WATER WELL OWNER and retain one for your records.