


1. LOCATION OF WATER WELL: Fraction NE SW NE Section Number 23 Township Number T 34 S Range Number R 34 EW  
 County Seward

Distance and direction from nearest town or city street address of well if located within city?  
2 West 3/4 North of Liberal

2. WATER WELL OWNER: Byron Bird  
 RR# St. Address, Box # : 2410 Rd F  
 City, State, ZIP Code : Liberal KS 67901  
 Board of Agriculture, Division of Water Resources  
 Application Number:

3. LOCATE WELL'S LOCATION WITH: 4. DEPTH OF COMPLETED WELL 615 ft. ELEVATION:

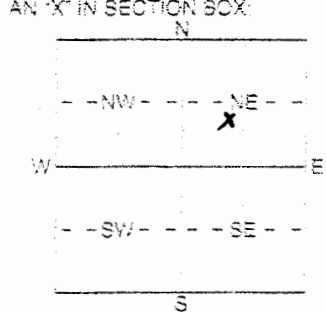

AN 'X' IN SECTION BOX:  
 Depth(s) Groundwater Encountered 1 290 ft. 2 ..... ft. 3 ..... ft.  
 WELL'S STATIC WATER LEVEL 290 ft. below land surface measured on mo/day/yr 8/29/06  
 Pump test data: Well water was ..... ft. after ..... hours pumping ..... gpm  
 Est. Yield ..... gpm: Well water was ..... ft. after ..... hours pumping ..... gpm  
 WELL WATER TO BE USED AS:  
 Domestic 3 Feedlot 6 Oil field water supply 9 Dewatering 12 Other (Specify below)  
 Irrigation 4 Industrial 7 Domestic (lawn & garden) 10 Monitoring well

Was a chemical/bacteriological sample submitted to Department? Yes ..... No  If yes, mo/day/yr sample was submitted  
 Water Well Disinfected? Yes  No

5. TYPE OF BLANK CASING USED:  
 Steel 3 RMP (SR) 6 Wrought Iron 8 Concrete tile CASING JOINTS: Glued ..... Cramped .....  
 PVC 4 ABS 7 Fiberglass ..... Eagle - 600 Welded .....  
 2 Brass 5 Other (specify below) Threaded

Blank casing diameter 5 in. to 6.15 ft. Dia. in. to ..... ft. Dia. in. to ..... ft. Dia. in. to ..... ft.  
 Casing height above land surface 18 in. weight ..... lbs/ft. Wall thickness or gauge No. SDR 2.1

TYPE OF SCREEN OR PERFORATION MATERIAL:  
 Steel 3 Stainless Steel 5 Fiberglass 7 PVC 10 Asbestos-Cement  
 Brass 4 Galvanized Steel 6 Concrete tile 8 RMP (SR) 11 Other (Specify)  
 9 ABS 12 None used (open hole)

SCREEN OR PERFORATION OPENINGS ARE:  
 1 Continuous slot  3/8" slot 5 Guazed wrapped 8 Saw out 11 None (open hole)  
 2 Louvered shutter 4 Key punched 305 - 395 6 Wire wrapped 9 Drilled holes  
 7 Toron 345 - 365 10 Other (specify) ..... ft.

SCREEN-PERFORATED INTERVALS: From 385 - 405 ft. to 425 - 445 ft. From 465 - 485 ft. to 505 - 525 ft.  
 From 545 ft. to 605 ft. From 585 ft. to 605 ft.  
 GRAVEL PACK INTERVALS: From 25 ft. to 615 ft. From ..... ft. to ..... ft.

6. GROUT MATERIAL: 1 Neat cement 2 Cement grout  Bentonite 4 Other  
 Grout intervals: From 5 ft. to 25 ft. From ..... ft. to ..... ft. From ..... ft. to ..... ft.

What is the nearest source of possible contamination:  
 1 Septic tank 4 Lateral lines 7 Pit only 10 Livestock pens 14 Abandoned water well  
 2 Sewer lines 5 Cess pool 8 Sewage lagoon 11 Fuel storage 15 Oil well Gas well  
 3 Watertight sewer lines 6 Seepage pit 9 Feedyard 12 Fertilizer storage 16 Other (specify below)  
 Direction from well? ..... How many feet? None observed

FROM	TO	LITHOLOGIC LOG	FROM	TO	PLUGGING INTERVALS
0	20	Top Soil & Sandy clay			
20	40	Fine Sand			
40	120	Sandy clay			
120	147	Fine Sand			
147	173	Sandy clay			
173	200	Caliche			
200	240	Sand med + a little clay			
240	260	Sandy clay			
260	410	Sand fine to med some clay			
410	420	clay			
420	500	Sand fine to med some clay			
500	550	Sandy clay			
550	580	Sandy fine to med a little clay			
580	620	Brown clay			

CONTRACTOR'S OR LANDOWNER'S CERTIFICATION: This water well was  constructed,  reconstructed, or  plugged under my jurisdiction and was completed on (mo/day/year) ..... and this record is true to the best of my knowledge and belief, Kansas Water Well Contractor's Licence No. 973 This Water Well Record was completed on (mo/day/yr) 8/30/06 under the business name of Tyler Water Well Inc by (signature) Deety G. H.