


1 LOCATION OF WATER WELL: County: Seward Fraction: Center SE 1/4 NW 1/4 Section Number: 5 Township Number: T 34 S Range Number: R 34 E/W

Distance and direction from nearest town or city street address of well if located within city?
6 North 5 1/4 West of Liberal, Kansas

2 WATER WELL OWNER: Carr Flynn Energy RR#, St. Address, Box #: Rt. 1 City, State, ZIP Code: Hennessey, Ok. 73742 Board of Agriculture, Division of Water Resources Application Number: T85-265

3 LOCATE WELL'S LOCATION WITH AN "X" IN SECTION BOX:

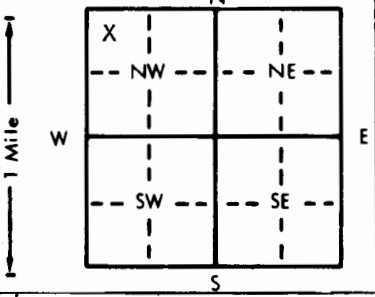

4 DEPTH OF COMPLETED WELL: 295 ft. ELEVATION:
 Depth(s) Groundwater Encountered 1. 165 ft. 2. ft. 3. ft.
 WELL'S STATIC WATER LEVEL 130 ft. below land surface measured on mo/day/yr 3-16-85
 Pump test data: Well water was 155 ft. after 2 hours pumping 60 gpm
 Est. Yield 65 gpm: Well water was ft. after hours pumping gpm
 Bore Hole Diameter 9 in. to 295 ft., and in. to ft.
 WELL WATER TO BE USED AS: 5 Public water supply 8 Air conditioning 11 Injection well
 1 Domestic 3 Feedlot 6 Oil field water supply 9 Dewatering 12 Other (Specify below)
 2 Irrigation 4 Industrial 7 Lawn and garden only 10 Observation well
 Was a chemical/bacteriological sample submitted to Department? Yes.....No X.....; If yes, mo/day/yr sample was submitted
 Water Well Disinfected? Yes X No

5 TYPE OF BLANK CASING USED: 1 Steel 3 RMP (SR) 5 Wrought iron 8 Concrete tile CASING JOINTS: Glued X Clamped
 2 PVC 4 ABS 6 Asbestos-Cement 9 Other (specify below) Welded
 7 Fiberglass Threaded
 Blank casing diameter 5 in. to 215 ft., Dia in. to ft., Dia in. to ft.
 Casing height above land surface 14 in., weight 200 lbs./ft. Wall thickness or gauge No. 0.265

TYPE OF SCREEN OR PERFORATION MATERIAL: 7 PVC 10 Asbestos-cement
 1 Steel 3 Stainless steel 5 Fiberglass 8 RMP (SR) 11 Other (specify)
 2 Brass 4 Galvanized steel 6 Concrete tile 9 ABS 12 None used (open hole)

SCREEN OR PERFORATION OPENINGS ARE: 5 Gauzed wrapped 8 Saw cut 11 None (open hole)
 1 Continuous slot 3 Mill slot 6 Wire wrapped 9 Drilled holes
 2 Louvered shutter 4 Key punched 7 Torch cut 10 Other (specify)

SCREEN-PERFORATED INTERVALS: From 130 ft. to 295 ft., From ft. to ft.
 From ft. to ft., From ft. to ft.
 GRAVEL PACK INTERVALS: From 120 ft. to 295 ft., From ft. to ft.
 From ft. to ft., From ft. to ft.

6 GROUT MATERIAL: 1 Neat cement 2 Cement grout 3 Bentonite 4 Other
 Grout Intervals: From 0 ft. to 10 ft., From ft. to ft., From ft. to ft.
 What is the nearest source of possible contamination: 10 Livestock pens 14 Abandoned water well
 1 Septic tank 4 Lateral lines 7 Pit privy 11 Fuel storage 15 Oil well/Gas well
 2 Sewer lines 5 Cess pool 8 Sewage lagoon 12 Fertilizer storage 16 Other (specify below)
 3 Watertight sewer lines 6 Seepage pit 9 Feedyard 13 Insecticide storage
 Direction from well? East How many feet? 240

FROM	TO	LITHOLOGIC LOG	FROM	TO	LITHOLOGIC LOG
0	130	<u>0</u> Overburden			
130	140	<u>0</u> Medium sand and clay			
140	220	<u>0</u> Blue clay			
220	240	<u>0</u> Medium sand			
240	270	<u>0</u> Fine sand and clay			
270	280	<u>0</u> Clay			
280	295	<u>0</u> Fine sand and clay			

7 CONTRACTOR'S OR LANDOWNER'S CERTIFICATION: This water well was (1) constructed, (2) reconstructed, or (3) plugged under my jurisdiction and was completed on (mo/day/year) 3-16-85 and this record is true to the best of my knowledge and belief. Kansas Water Well Contractor's License No. 142 This Water Well Record was completed on (mo/day/yr) 3-18-85 under the business name of T & W Water Well Service by (signature) [Signature]

INSTRUCTIONS: Use typewriter or ball point pen, PLEASE PRESS FIRMLY and PRINT clearly. Please fill in blanks, underline or circle the correct answers. Send top three copies to Kansas Department of Health and Environment, Division of Environment, Environmental Geology Section, Topeka, KS 66620. Send one to WATER WELL OWNER and retain one for your records.

OFFICE USE ONLY
T
34
R
34
END
SEC. 5
C 1/4 SE 1/4 NW 1/4