

USE TYPEWRITER OR BALL POINT PEN-PRESS FIRMLY, PRINT CLEARLY.


T R EW sec 1/4 1/4 1/4 No.

WATER WELL RECORD
KSA 82a-1201-1215

Kansas State Dept. Of Health
(Water Well Contractors)
Forbes-Bldg. 740
Topeka, Kansas 66620

1 Location of well: County Seward Township name _____ Fraction SE, SE, NW Section number 10 Town number 34S Range number 34W

Distance and direction from nearest town or city: 4 Miles N & 4 1/2 miles W & 1/2 S of Liberal, Kansas
Street address of well location if in city: _____
3 Owner of well: Wayne Wettstein
Address: R.R. Liberal, Kansas 67901

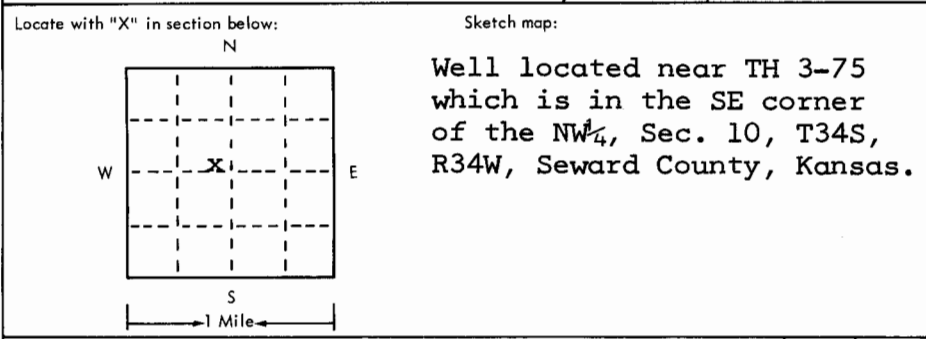

4 Well depth: 600 ft. Date of completion 11-20-75
Well diameter 28 in.
5 Cable tool Rotary Driven Dug
 Hollow rod Jetted Bored Reverse rotary
6 Use: Domestic Public supply Industry
 Irrigation Air conditioning Commercial
 Test well _____
7 Casing: Material Stl. Height: above/below
Threaded Welded Surface 12 in.
Diam. 16 in. Weight 39 lbs./ft. 16 in. to 198 ft. depth Drive shoe? Yes No
_____ in. to _____ ft. depth

2	Type and color of material	From	To
	Top soil	0	3
	Fine sand	3	22
	Brown clay	22	35
	Fine sand	35	46
	Brown clay	46	54
	Fine to coarse sand	54	66
	Tan clay	66	80
	Fine to coarse sand	80	114
	Tan and white clay with caliche streaks	114	190
	Fine to coarse sand	190	218
	Very fine to fine sand	218	224
	Fine to coarse sand	224	262
	Fine to coarse sand some clay streaks	261	420
	XXX Fine to medium sand lots of clay lenses	420	536
	Fine to medium sand some clay lenses	536	600
	(use a second sheet if needed)		

8 Screen: Manufacturer Foster & Cook
Type Mill slot & louver Dia. 16"
Slot/gauze 1/8" Length 402
Set between 198 ft. and 600 ft. _____
Fittings: Gravel pack Yes No Size range of material 1.1 mm to 5.5 mm
9 Static water level: 180 ft. below land surface Date 10-9-75
10 Pumping level below land surfaces: 334 ft. after 1 hrs. pumping 1266 g.p.m.
_____ ft. after _____ hrs. pumping _____ g.p.m.
Estimated maximum yield 1200 g.p.m.
11 Water sample submitted: Yes No Date _____
12 Well head completion: Pitless adapter Inches above grade
13 Well grouted? Yes No
 Neat cement Bentonite _____
Depth: From 0 ft. to 10 ft.
14 Nearest source of possible contamination: unk
ft. _____ Direction _____ Type _____
Well disinfected upon completion? Yes No
15 Pump: Not installed
Manufacturer's name Layne & Bowler
Model number 12K HP 130 Volts _____
Length of drop pipe 400 ft. capacity 1200 g.p.m.
Type: Submersible Turbine
 Jet Reciprocating
 Centrifugal Other

16 Remarks: elevation
Topography: Hill Slope Upland Valley

17 Water well contractor's certification:
This well was drilled under my jurisdiction and this report is true to the best of my knowledge and belief.
Layne-Western Company, Inc. 1500
Business name _____ License No. _____
Address Garden City, Kansas
Signed [Signature] Date 20 Nov 75
Authorized representative

34
34 W
10
SE SE NW