


1 LOCATION OF WATER WELL: County: **Seward** Fraction: **NE 1/4 SW 1/4 NE 1/4** Section Number: **14** Township Number: **T 34 S** Range Number: **R 34 E/W**

Distance and direction from nearest town or city street address of well if located within city?
4 miles Northwest of Liberal

2 WATER WELL OWNER: **Triad Drilling** #1-14 Stephens
 RR#, St. Address, Box #: **5400 N. Grand Blvd.** Board of Agriculture, Division of Water Resources
 City, State, ZIP Code: **Oklahoma City, OK 73112** Application Number: **900314**

3 LOCATE WELL'S LOCATION WITH AN "X" IN SECTION BOX:

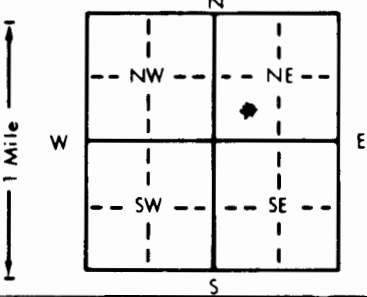

4 DEPTH OF COMPLETED WELL: **280** ft. ELEVATION: ft.
 Depth(s) Groundwater Encountered 1. **140** ft. 2. ft. 3. ft.
 WELL'S STATIC WATER LEVEL: **140** ft. below land surface measured on **7-28-90**
 Pump test data: Well water was **130** ft. after **2** hours pumping **75** gpm
 Est. Yield **80** gpm: Well water was ft. after hours pumping gpm
 Bore Hole Diameter: **9** in. to **280** ft., and in. to ft.
 WELL WATER TO BE USED AS: 5 Public water supply 8 Air conditioning 11 Injection well
 1 Domestic 3 Feedlot 6 Oil field water supply 9 Dewatering 12 Other (Specify below)
 2 Irrigation 4 Industrial 7 Lawn and garden only 10 Monitoring well
 Was a chemical/bacteriological sample submitted to Department? Yes.....No **X**.....; If yes, mo/day/yr sample was submitted
 Water Well Disinfected? Yes **X** No

5 TYPE OF BLANK CASING USED: 1 Steel 3 RMP (SR) 5 Wrought iron 8 Concrete tile CASING JOINTS: Glued **X** Clamped
 2 PVC 4 ABS 6 Asbestos-Cement 9 Other (specify below) Welded
 7 Fiberglass Threaded
 Blank casing diameter: **5** in. to **180** ft., Dia. in. to ft., Dia. in. to ft.
 Casing height above land surface: **14** in., weight **200** lbs./ft. Wall thickness or gauge No. **0.265**

TYPE OF SCREEN OR PERFORATION MATERIAL: 7 PVC 10 Asbestos-cement
 1 Steel 3 Stainless steel 5 Fiberglass 8 RMP (SR) 11 Other (specify)
 2 Brass 4 Galvanized steel 6 Concrete tile 9 ABS 12 None used (open hole)

SCREEN OR PERFORATION OPENINGS ARE: 5 Gauzed wrapped 8 Saw cut 11 None (open hole)
 1 Continuous slot 3 Mill slot 6 Wire wrapped 9 Drilled holes
 2 Louvered shutter 4 Key punched 7 Torch cut 10 Other (specify)

SCREEN-PERFORATED INTERVALS: From **180** ft. to **280** ft., From ft. to ft.
 From ft. to ft., From ft. to ft.
 GRAVEL PACK INTERVALS: From **130** ft. to **280** ft., From ft. to ft.
 From ft. to ft., From ft. to ft.

6 GROUT MATERIAL: 1 Neat cement 2 Cement grout 3 Bentonite 4 Other Hole plug
 Grout Intervals: From **0** ft. to **20** ft., From ft. to ft., From ft. to ft.
 What is the nearest source of possible contamination: 10 Livestock pens 14 Abandoned water well
 1 Septic tank 4 Lateral lines 7 Pit privy 11 Fuel storage 15 Oil well/Gas well
 2 Sewer lines 5 Cess pool 8 Sewage lagoon 12 Fertilizer storage 16 Other (specify below)
 3 Watertight sewer lines 6 Seepage pit 9 Feedyard 13 Insecticide storage
 Direction from well? **West** How many feet? **250**

FROM	TO	LITHOLOGIC LOG	FROM	TO	PLUGGING INTERVALS
0	3	Topsoil			
3	20	Sandy clay			
20	57	Brown clay			
57	67	Sand and Gravel			
67	103	Brown clay			
103	180	Brown clay and fine sand streaks			
180	260	Coarse sand and thin clay streaks			
260	270	Clay			

7 CONTRACTOR'S OR LANDOWNER'S CERTIFICATION: This water well was (1) constructed, (2) reconstructed, or (3) plugged under my jurisdiction and was completed on (mo/day/year) **7-28-90** and this record is true to the best of my knowledge and belief. Kansas Water Well Contractor's License No. **142** This Water Well Record was completed on (mo/day/yr) **8-8-90** under the business name of **T & W Water Well Service, Inc.** by (signature) *[Signature]*