


1 LOCATION OF WATER WELL: Fraction C 1/4 SE 1/4 SE 1/4 Section Number 23 Township Number T 34S S Range Number R 34W EW

Distance and direction from nearest town or city street address of well if located within city?
 3 MILES NW OF LIBERAL, KS

2 WATER WELL OWNER: GABBERT-JONES, INC #3 UNDERWOOD "A"
 RR#, St. Address, Box # : 333 E ENGLISH, #215 Board of Agriculture, Division of Water Resources
 City, State, ZIP Code : WICHITA, KS 67202 Application Number: 930401

3 LOCATE WELL'S LOCATION WITH AN "X" IN SECTION BOX:

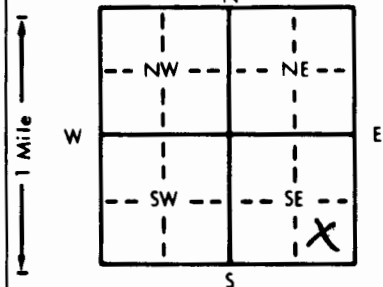

4 DEPTH OF COMPLETED WELL 300 ft. ELEVATION:
 Depth(s) Groundwater Encountered 1. 130 ft. 2. ft. 3. ft.
 WELL'S STATIC WATER LEVEL 130 ft. below land surface measured on mo/day/yr 10-14-93
 Pump test data: Well water was 145 ft. after 1 hours pumping 85 gpm
 Est. Yield 85 gpm: Well water was ft. after hours pumping gpm
 Bore Hole Diameter 9 1/2 in. to 300 ft., and in. to ft.
 WELL WATER TO BE USED AS:
 1 Domestic 3 Feedlot 6 Oil field water supply 9 Dewatering 11 Injection well
 2 Irrigation 4 Industrial 7 Lawn and garden only 10 Monitoring well 12 Other (Specify below)
 Was a chemical/bacteriological sample submitted to Department? Yes No x; If yes, mo/day/yr sample was submitted
 Water Well Disinfected? Yes x No

5 TYPE OF BLANK CASING USED:
 1 Steel 3 RMP (SR) 5 Wrought iron 8 Concrete tile CASING JOINTS: Glued x Clamped
 2 PVC 4 ABS 6 Asbestos-Cement 9 Other (specify below) Welded
 7 Fiberglass Threaded
 Blank casing diameter 5 in. to 300 ft., Dia in. to ft., Dia in. to ft.
 Casing height above land surface 24 in., weight 2.902 lbs./ft. Wall thickness or gauge No. 280 SDR 21
 TYPE OF SCREEN OR PERFORATION MATERIAL:
 1 Steel 3 Stainless steel 5 Fiberglass 7 PVC 10 Asbestos-cement
 2 Brass 4 Galvanized steel 6 Concrete tile 8 RMP (SR) 11 Other (specify)
 12 None used (open hole)
 SCREEN OR PERFORATION OPENINGS ARE:
 1 Continuous slot 3 Mill slot 5 Gauzed wrapped 8 Saw cut 11 None (open hole)
 2 Louvered shutter 4 Key punched 6 Wire wrapped 9 Drilled holes
 7 Torch cut 10 Other (specify)
 SCREEN-PERFORATED INTERVALS: From 220 ft. to 300 ft., From ft. to ft.
 From ft. to ft., From ft. to ft.
 GRAVEL PACK INTERVALS: From 15 ft. to 300 ft., From ft. to ft.
 From ft. to ft., From ft. to ft.

6 GROUT MATERIAL: 1 Heat cement 2 Cement grout 3 Bentonite 4 Other HOLE PLUG
 Grout Intervals: From 1 ft. to 20 ft., From ft. to ft., From ft. to ft.
 What is the nearest source of possible contamination:
 1 Septic tank 4 Lateral lines 7 Pit privy 10 Livestock pens 14 Abandoned water well
 2 Sewer lines 5 Cess pool 8 Sewage lagoon 11 Fuel storage 15 Oil well/Gas well
 3 Watertight sewer lines 6 Seepage pit 9 Feedyard 12 Fertilizer storage 16 Other (specify below)
 13 Insecticide storage
 Direction from well? SOUTHEAST How many feet? 190

FROM	TO	LITHOLOGIC LOG	FROM	TO	PLUGGING INTERVALS
0	20	TOP SOIL			
20	120	SANDY CLAY			
120	160	FINE TO MED. SAND & STREAKS OF CLAY			
160	180	FINE SAND STONE & ESTREAKS OF CLAY			
180	255	FINE TO COARSE SAND			
255	257	SANDY BLUE CLAY			
257	280	FINE TO MED. SAND			
280	300	SANDY BLUE CLAY			

7 CONTRACTOR'S OR LANDOWNER'S CERTIFICATION: This water well was (1) constructed, (2) reconstructed, or (3) plugged under my jurisdiction and was completed on (mo/day/year) 10-14-93 and this record is true to the best of my knowledge and belief. Kansas Water Well Contractor's License No. KWWCL-430 This Water Well Record was completed on (mo/day/yr) 10-14-93 under the business name of HOWARD DRUG CO. BOX 806 BEAVER, OK 73932 by (signature) *Alvin Howard*

INSTRUCTIONS: Use typewriter or ball point pen. PLEASE PRESS FIRMLY and PRINT clearly. Please fill in blanks, underline or circle the correct answers. Send top three copies to Kansas Department of Health and Environment, Bureau of Water, Topeka, Kansas 66620-0001. Telephone: 913-296-5545. Send one to WATER WELL OWNER and retain one for your records.