


LOCATION OF WATER WELL: County: Seward	Fraction NE 1/4 NE 1/4 NW 1/4	Section Number 30	Township Number T 34 S	Range Number R 34 <u>EW</u>
--	---	-----------------------------	----------------------------------	---------------------------------------

Distance and direction from nearest town or city street address of well if located within city?

7 1/2 Miles West of Liberal, Kansas

WATER WELL OWNER: **Mr. D. T. Gammel**
 RR#, St. Address, Box #: **Box 156**
 City, State, ZIP Code: **Liberal, Kansas 67901**
 Board of Agriculture, Division of Water Resources
 Application Number: **---**

LOCATE WELL'S LOCATION WITH AN "X" IN SECTION BOX:

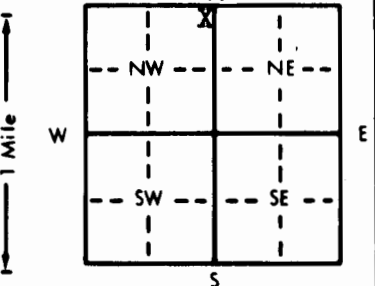

DEPTH OF COMPLETED WELL: **290** ft. ELEVATION: **Slope**
 Depth(s) Groundwater Encountered: 1. **Not available** ft. 2. _____ ft. 3. _____ ft.
 WELL'S STATIC WATER LEVEL: **110** ft. below land surface measured on mo/day/yr **July 8, 1988**
 Pump test data: Well water was _____ ft. after _____ hours pumping _____ gpm
 Est. Yield: **20** gpm: Well water was _____ ft. after _____ hours pumping _____ gpm
 Bore Hole Diameter: **10** in. to **290** ft., and _____ in. to _____ ft.
 WELL WATER TO BE USED AS:
 5 Public water supply 8 Air conditioning 11 Injection well
 3 Domestic 3 Feedlot 6 Oil field water supply 9 Dewatering 12 Other (Specify below)
 2 Irrigation 4 Industrial 7 Lawn and garden only 10 Observation well
 Was a chemical/bacteriological sample submitted to Department? Yes _____ No **XX**; If yes, mo/day/yr sample was submitted _____
 Water Well Disinfected? Yes **XX** No _____

TYPE OF BLANK CASING USED:
 1 Steel 3 RMP (SR)
 PVC 4 ABS
 5 Wrought iron 8 Concrete tile CASING JOINTS: Glued **XX** Clamped _____
 6 Asbestos-Cement 9 Other (specify below) Welded _____
 7 Fiberglass _____ Threaded _____

Blank casing diameter: **5** in. to **250** ft., Dia _____ in. to _____ ft., Dia _____ in. to _____ ft.
 Casing height above land surface: **15** in., weight **2.8** lbs./ft. Wall thickness or gauge No. **265**

TYPE OF SCREEN OR PERFORATION MATERIAL:
 PVC 10 Asbestos-cement
 1 Steel 3 Stainless steel 5 Fiberglass 8 RMP (SR) 11 Other (specify) _____
 2 Brass 4 Galvanized steel 6 Concrete tile 9 ABS 12 None used (open hole)

SCREEN OR PERFORATION OPENINGS ARE:
 1 Continuous slot 3 Mill slot 5 Gauzed wrapped Saw cut 11 None (open hole)
 2 Louvered shutter 4 Key punched 6 Wire wrapped 9 Drilled holes
 7 Torch cut 10 Other (specify) _____

SCREEN-PERFORATED INTERVALS: From **250** ft. to **290** ft., From _____ ft. to _____ ft.
 From _____ ft. to _____ ft., From _____ ft. to _____ ft.
 GRAVEL PACK INTERVALS: From **0** ft. to **16** ft., From _____ ft. to _____ ft.
 From **40** ft. to **290** ft., From _____ ft. to _____ ft.

GROUT MATERIAL: 1 Neat cement 2 Cement grout 3 Bentonite Other **Baroid Hole Plug**
 Grout Intervals: From **16** ft. to **40** ft., From _____ ft. to _____ ft., From _____ ft. to _____ ft.

What is the nearest source of possible contamination:
 Septic tank 4 Lateral lines 7 Pit privy 10 Livestock pens 14 Abandoned water well
 2 Sewer lines 5 Cess pool 8 Sewage lagoon 11 Fuel storage 15 Oil well/Gas well
 3 Watertight sewer lines 6 Seepage pit 9 Feedyard 12 Fertilizer storage 16 Other (specify below)
 13 Insecticide storage

Direction from well? **North** How many feet? **100**

FROM	TO	LITHOLOGIC LOG	FROM	TO	LITHOLOGIC LOG
0	3	Topsoil			
3	16	Fine Sand			
16	91	Clay			
91	108	Fine Sand			
108	179	Clay			
179	288	Clay, Fine Sand & Gravel			
288	290	Clay			

CONTRACTOR'S OR LANDOWNER'S CERTIFICATION: This water well was (1) constructed, (2) reconstructed, or (3) plugged under my jurisdiction and was completed on (mo/day/year) **July 13, 1988** and this record is true to the best of my knowledge and belief. Kansas Water Well Contractor's License No. **252**. This Water Well Record was completed on (mo/day/year) **July 20, 1988** under the business name of **Friesen Windmill & Supply Inc.** by (signature) _____

INSTRUCTIONS: Use typewriter or ball point pen. PLEASE PRESS FIRMLY and PRINT clearly. Please fill in blanks, underline or circle the correct answers. Send top three copies to Kansas Department of Health and Environment, Bureau of Water Protection, Topeka, Kansas 66620-7320, Telephone: 913-862-9360. Send one to WATER WELL OWNER and retain one for your records.

4070000078-01

OFFICE USE ONLY
T
R
EW
SEC.