


1 LOCATION OF WATER WELL:	Fraction	Section Number	Township Number	Range Number
County: <b>Seward</b>	<b>NW</b> 1/4 <b>SW</b> 1/4 <b>NE</b> 1/4	<b>35</b>	T <b>34</b> S	R <b>34</b> EW

Distance and direction from nearest town or city street address of well if located within city? **From Liberal go West on 2nd Street road to 1st road go North 3/4 mi West into location.**

2 WATER WELL OWNER: **Printz Estate c/o Don Garwood Anadarko Production**  
 RR#, St. Address, Box #: **1145 North Prospect** Board of Agriculture, Division of Water Resources  
 City, State, ZIP Code: **Liberal, Kansas 67901** Application Number: **T 84-998**

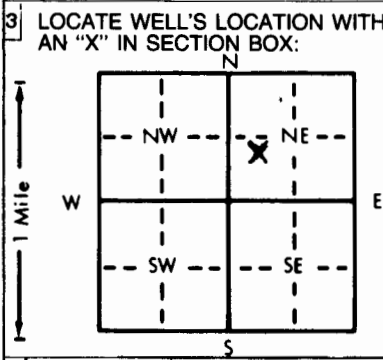

4 DEPTH OF COMPLETED WELL... **265** ft. ELEVATION: .....

Depth(s) Groundwater Encountered 1. **154** ft. 2. .... ft. 3. .... ft.

WELL'S STATIC WATER LEVEL **111** ft. below land surface measured on mo/day/yr **1/26/85**

Pump test data: Well water was ..... ft. after ..... hours pumping ..... gpm

Est. Yield **75** gpm: Well water was ..... ft. after ..... hours pumping ..... gpm

Bore Hole Diameter **9** in. to **265** ft., and ..... in. to ..... ft.

WELL WATER TO BE USED AS:

5 Public water supply	8 Air conditioning	11 Injection well
1 Domestic	3 Feedlot	<u>6 Oil field water supply</u>
2 Irrigation	4 Industrial	9 Dewatering
	7 Lawn and garden only	10 Observation well

Was a chemical/bacteriological sample submitted to Department? Yes.....No.....; If yes, mo/day/yr sample was submitted

Water Well Disinfected? Yes No

5 TYPE OF BLANK CASING USED:

1 Steel	3 RMP (SR)	5 Wrought iron	8 Concrete tile	CASING JOINTS: Glued ..... Clamped .....
2 PVC	4 ABS	6 Asbestos-Cement	9 Other (specify below)	Welded .....
		7 Fiberglass		Threaded .....

Blank casing diameter ..... in. to ..... ft., Dia ..... in. to ..... ft., Dia ..... in. to ..... ft.

Casing height above land surface ..... in., weight ..... lbs./ft. Wall thickness or gauge No. ....

TYPE OF SCREEN OR PERFORATION MATERIAL:

1 Steel	3 Stainless steel	5 Fiberglass	7 PVC	10 Asbestos-cement
2 Brass	4 Galvanized steel	6 Concrete tile	8 RMP (SR)	11 Other (specify) .....
			9 ABS	12 None used (open hole)

SCREEN OR PERFORATION OPENINGS ARE:

1 Continuous slot	3 Mill slot	5 Gauzed wrapped	8 Saw cut	11 None (open hole)
2 Louvered shutter	4 Key punched	6 Wire wrapped	9 Drilled holes	
		7 Torch cut	10 Other (specify) .....	

SCREEN-PERFORATED INTERVALS: From ..... ft. to ..... ft., From ..... ft. to ..... ft.

GRAVEL PACK INTERVALS: From ..... ft. to ..... ft., From ..... ft. to ..... ft.

6 GROUT MATERIAL: 1 Neat cement 2 Cement grout 3 Bentonite 4 Other .....

Grout Intervals: From ..... ft. to ..... ft., From ..... ft. to ..... ft., From ..... ft. to ..... ft.

What is the nearest source of possible contamination:

1 Septic tank	4 Lateral lines	7 Pit privy	10 Livestock pens	14 Abandoned water well
2 Sewer lines	5 Cess pool	8 Sewage lagoon	11 Fuel storage	15 Oil well/Gas well
3 Watertight sewer lines	6 Seepage pit	9 Feedyard	12 Fertilizer storage	16 Other (specify below)
			13 Insecticide storage	

Direction from well? How many feet?

FROM	TO	LITHOLOGIC LOG	FROM	TO	LITHOLOGIC LOG
0	4	dirt .55 cu. feet of dirt			
4	14	cement 1.36 cu. feet of cement			
14	101	sand 11.87 cu. feet of sand			
101	111	cement 1.36 cu. feet of cement			
111	265	sand 21.01 cu. feet of sand			

7 CONTRACTOR'S OR LANDOWNER'S CERTIFICATION: This water well was (1) constructed, (2) reconstructed, or (3) plugged under my jurisdiction and was completed on (mo/day/year) .. **March 25, 1985** ..... and this record is true to the best of my knowledge and belief. Kansas Water Well Contractor's License No. .... **118** ..... This Water Well Record was completed on (mo/day/yr) ..... **March 27, 1985** ..... under the business name of **Carlile Water Well Service, Inc.** by (signature) *[Signature]*

INSTRUCTIONS: Use typewriter or ball point pen, PLEASE PRESS FIRMLY and PRINT clearly. Please fill in blanks, underline or circle the correct answers. Send top three copies to Kansas Department of Health and Environment, Division of Environment, Environmental Geology Section, Topeka, KS 66620. Send one to WATER WELL OWNER and retain one for your records.