

## WATER WELL RECORD Form WWC-5 KSA 82a-1212

1 LOCATION OF WATER WELL: Fraction NE 1/4 SW 1/4 NW 1/4 Section Number 36 Township Number T 34 S Range Number R 35 EW


County: Stevens Distance and direction from nearest town or city street address of well if located within city? Stevens Co Intersection of Roads D#27 3/4 mile North and East 500 ft

2 WATER WELL OWNER: Mid America Cattle Co. (Walter Boesley)

RR#, St. Address, Box # P.O. Box 818 Board of Agriculture, Division of Water Resources

City, State, ZIP Code Hugoton, KS 67951 Application Number:

3 LOCATE WELL'S LOCATION WITH AN "X" IN SECTION BOX:

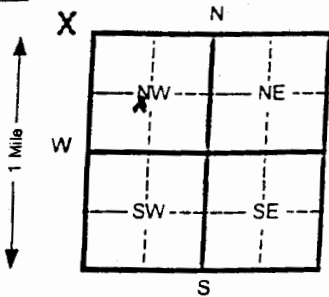

4 DEPTH OF COMPLETED WELL 140 ft. ELEVATION:

Depth(s) Groundwater Encountered 1 1 ft. 2 1 ft. 3 1 ft.

WELL'S STATIC WATER LEVEL Dry ft. below land surface measured on mo/day/yr

Pump test data: Well water was 1 ft. after 1 hours pumping 1 gpm

Est. Yield 1 gpm: Well water was 1 ft. after 1 hours pumping 1 gpm

Bore Hole Diameter in. to 1 ft. and in. to 1 ft.

WELL WATER TO BE USED AS: 5 Public water supply 8 Air conditioning 11 Injection well

1 Domestic 3 Feed lot 6 Oil field water supply 9 Dewatering 12 Other (Specify below)

2 Irrigation 4 Industrial 7 Lawn and garden (domestic) 10 Monitoring well Livestock

Was a chemical/bacteriological sample submitted to Department? Yes No If yes, mo/day/yr sample was submitted

Water Well Disinfected? Yes No

5 TYPE OF BLANK CASING USED:

1 Steel 3 RMP (SR) 5 Wrought Iron 8 Concrete tile CASING JOINTS: Glued Clamped

2 PVC 4 ABS 6 Asbestos-Cement 9 Other (specify below) Welded Threaded

7 Fiberglass

Blank casing diameter 5 in. to 1 ft. Dia 1 in. to 1 ft. Dia 1 in. to 1 ft.

Casing height above land surface 1 in., weight 1 lbs./ft. Wall thickness or gauge No. 1

TYPE OF SCREEN OR PERFORATION MATERIAL:

1 Steel 3 Stainless steel 5 Fiberglass 8 RMP (SR) 10 Asbestos-cement

2 Brass 4 Galvanized steel 6 Concrete tile 9 ABS 11 Other (specify)

SCREEN OR PERFORATION OPENINGS ARE:

1 Continuous slot 5 Gauzed wrapped 8 Saw cut 11 None (open hole)

2 Louvered shutter 4 Key punched 6 Wire wrapped 9 Drilled holes

SCREEN-PERFORATED INTERVALS: From 1 ft. to 1 ft. From 1 ft. to 1 ft. From 1 ft. to 1 ft.

GRAVEL PACK INTERVALS: From 1 ft. to 1 ft. From 1 ft. to 1 ft. From 1 ft. to 1 ft.

From 1 ft. to 1 ft. From 1 ft. to 1 ft. From 1 ft. to 1 ft.

6 GROUT MATERIAL: 1 Neat cement 2 Cement grout 3 Bentonite 4 Other

Grout intervals From 1 ft. to 1 ft. From 1 ft. to 1 ft. From 1 ft. to 1 ft.

What is the nearest source of possible contamination:

1 Septic tank 4 Lateral lines 7 Pit privy 10 Livestock pens 14 Abandoned water well

2 Sewer lines 5 Cess pool 8 Sewage lagoon 11 Fuel storage 15 Oil well/ Gas well

3 Watertight sewer lines 6 Seepage pit 9 Feedyard 12 Fertilizer storage 16 Other (specify below)

13 Insecticide storage NONE

Direction from well? How many feet?

FROM TO CODE LITHOLOGIC LOG FROM TO PLUGGING INTERVALS

140 24 Compacted Fill

24 5 Bentonite Plug

7 CONTRACTOR'S OR LANDOWNER'S CERTIFICATION: This water well was (1) constructed, (2) reconstructed, or (3) plugged under my jurisdiction and was

completed on (mo/day/yr) 1-19-2011 and this record is true to the best of my knowledge and belief. Kansas

Water Well Contractor's License No. 473 This Water Well Record was completed on (mo/day/yr) 1-20-2011

under the business name of Tyler Water Well Serv by (signature) [Signature]

INSTRUCTIONS: Please fill in blanks and circle the correct answers. Send three copies to Kansas Department of Health and Environment, Bureau of Water, Topeka.

Kansas 66620-0001. Telephone: 913-296-5545. Send one to WATER WELL OWNER and retain one for your records.

[Signature]