

USE TYPEWRITER OR BALL  
POINT PEN-PRESS FIRMLY,  
PRINT CLEARLY.

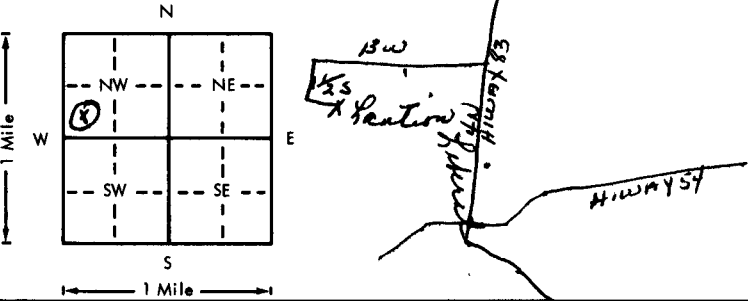
WATER WELL RECORD  
KSA 82a-1201-1215

Kansas Department of Health and  
Environment-Division of Environment  
(Water well Contractors)  
Topeka, Kansas 66620

CWW Inv. # 12700

1. Location of well:	County <b>Stevens</b>	Fraction <b>1/4 SW 1/4 NW 1/4</b>	Section number <b>17</b>	Township number <b>T 34 S</b>	Range number <b>R 35 E/W</b>
----------------------	--------------------------	--------------------------------------	-----------------------------	----------------------------------	---------------------------------

2. Distance and direction from nearest town or city: **4 north of Liberal, 13 west, 1 1/2 south, east to loc.**  
Street address of well location if in city: \_\_\_\_\_  
3. Owner of well: **Cities Service Oil Co.**  
R.R. or street: **3545 N.W. 58th. st.**  
City, state, zip code: **Oklahoma City, Oklahoma 73112**

4. Locate with "X" in section below: 	6. Bore hole dia. <b>9</b> in. Completion date <b>9-14-76</b> Well depth <b>280</b> ft.
7. <input checked="" type="checkbox"/> Cable tool <input checked="" type="checkbox"/> Rotary <input type="checkbox"/> Driven <input type="checkbox"/> Dug <input type="checkbox"/> Hollow rod <input type="checkbox"/> Jetted <input type="checkbox"/> Bored <input type="checkbox"/> Reverse rotary	
8. Use: <input type="checkbox"/> Domestic <input type="checkbox"/> Public supply <input type="checkbox"/> Industry <input type="checkbox"/> Irrigation <input type="checkbox"/> Air conditioning <input type="checkbox"/> Stock <input type="checkbox"/> Lawn <input checked="" type="checkbox"/> Oil field water <input type="checkbox"/> Other	
9. Casing: Material _____ Height: Above or below Threaded _____ Welded _____ Surface <b>28</b> in. RMP _____ PVC <input checked="" type="checkbox"/> Weight <b>2.18</b> lbs./ft. Dia. <b>5</b> in. to <b>175</b> ft. depth Wall Thickness: inches or Dia. <b>5</b> in. to <b>280</b> ft. depth gage No. <b>265</b>	
10. Screen: Manufacturer's name _____ <b>sawed perf.</b> Type <b>PVC</b> Dia. <b>5"</b> Slot/gauze <b>.030</b> Length <b>100</b> Set between <b>175</b> ft. and <b>275</b> ft. _____ ft. and _____ ft. Gravel pack? <b>yes</b> Size range of material <b>1/8 - 3/16</b>	
11. Static water level: _____ mo./day/yr. <b>155</b> ft. below land surface Date <b>9-14-76</b>	
12. Pumping level below land surfaces: _____ ft. after _____ hrs. pumping _____ g.p.m. _____ ft. after _____ hrs. pumping _____ g.p.m. Estimated maximum yield <b>60</b> g.p.m.	
13. Water sample submitted: _____ mo./day/yr. Yes <input checked="" type="checkbox"/> No <input type="checkbox"/> Date _____	
14. Well head completion: <input type="checkbox"/> Pitless adapter <input type="checkbox"/> _____ inches above grade	
15. Well grouted? <b>yes</b> With: <input checked="" type="checkbox"/> Neat cement <input type="checkbox"/> Bentonite <input type="checkbox"/> Concrete Depth: From <b>0</b> ft. to <b>10</b> ft.	
16. Nearest source of possible contamination: ft. <b>100</b> Direction <b>NE</b> Type <b>oil well</b> Well disinfected upon completion? <input checked="" type="checkbox"/> Yes <input type="checkbox"/> No	
17. Pump: <input checked="" type="checkbox"/> Not installed Manufacturer's name _____ Model number _____ HP _____ Volts _____ Length of drop pipe _____ ft. capacity _____ g.p.m. Type: <input type="checkbox"/> Submersible <input type="checkbox"/> Turbine <input type="checkbox"/> Jet <input type="checkbox"/> Reciprocating <input type="checkbox"/> Centrifugal <input type="checkbox"/> Other	
(Use a second sheet if needed)	

18. Elevation:  Topography: <input type="checkbox"/> Hill <input type="checkbox"/> Slope <input checked="" type="checkbox"/> Upland <input type="checkbox"/> Valley	19. Remarks:  20. Water well contractor's certification: This well was drilled under my jurisdiction and this report is true to the best of my knowledge and belief. <b>Carlile Water Well 118</b> Business name _____ License No. _____ Address <b>Box 275, Liberal, Ks.</b> Signed <b>Edward E. Means</b> Date <b>10-8-76</b> Authorized representative
---	---