WATER WELL RECORD Form WWC-5 KSA 82a-1212

1 LOCATION OF WATER WELL: County: Stevens | Fraction: SE ¼ SE ¼ SE ¼ | Section Number: 17 | Township Number: T 34 S | Range Number: R 35 E/W

Distance and direction from nearest town or city street address of well if located within city?
12 West, 3 North of Liberal, Ks.

2 WATER WELL OWNER: Wilbur K DeCamp
RR#, St. Address, Box # : Rt. 1, Box 51
City, State, ZIP Code : Hugoton, Kansas 67951
Board of Agriculture, Division of Water Resources Application Number: ----

3 LOCATE WELL'S LOCATION WITH AN "X" IN SECTION BOX:

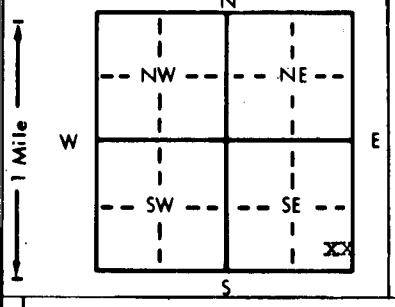

4 DEPTH OF COMPLETED WELL 367 ft. ELEVATION: Upland
Depth(s) Groundwater Encountered 1. Not available ft. 2. ft. 3. ft.
WELL'S STATIC WATER LEVEL 125 ft. below land surface measured on mo/day/yr August 26, 1981
Pump test data: Well water was ft. after hours pumping gpm
Est. Yield 80 gpm: Well water was ft. after hours pumping gpm
Bore Hole Diameter 9 7/8 in. to 367 ft., and in. to ft.
WELL WATER TO BE USED AS: XX 1 Domestic 2 Irrigation 3 Feedlot 4 Industrial 5 Public water supply 6 Oil field water supply 7 Lawn and garden only 8 Air conditioning 9 Dewatering 10 Observation well 11 Injection well 12 Other (Specify below)
Was a chemical/bacteriological sample submitted to Department? Yes ..... No XX; If yes, mo/day/yr sample was submitted
Water Well Disinfected? Yes XXX No

5 TYPE OF BLANK CASING USED: XX2 PVC | 1 Steel | 3 RMP (SR) | 4 ABS | 5 Wrought iron | 6 Asbestos-Cement | 7 Fiberglass | 8 Concrete tile | 9 Other (specify below)
CASING JOINTS: Glued XXX Clamped Welded Threaded
Blank casing diameter 5 in. to 247 ft., Dia 267 in. to 307 ft., Dia in. to ft.
Casing height above land surface 12 in., weight 2.8 lbs./ft. Wall thickness or gauge No. .265
TYPE OF SCREEN OR PERFORATION MATERIAL: XXX PVC | 1 Steel | 2 Brass | 3 Stainless steel | 4 Galvanized steel | 5 Fiberglass | 6 Concrete tile | 7 RMP (SR) | 8 ABS | 9 Other (specify) | 10 Asbestos-cement | 11 Other (specify) | 12 None used (open hole)
SCREEN OR PERFORATION OPENINGS ARE: XX 1 Continuous slot | 2 Louvered shutter | 3 Mill slot | 4 Key punched | 5 Gauzed wrapped | 6 Wire wrapped | 7 Torch cut | 8 Saw cut | 9 Drilled holes | 10 Other (specify) | 11 None (open hole)
SCREEN-PERFORATED INTERVALS: From 247 ft. to 267 ft., From ft. to ft.
From 307 ft. to 367 ft., From ft. to ft.
GRAVEL PACK INTERVALS: From 14 ft. to 367 ft., From ft. to ft.
From ft. to ft., From ft. to ft.

6 GROUT MATERIAL: XXX Neat cement | 2 Cement grout | 3 Bentonite | 4 Other
Grout Intervals: From 4 ft. to 14 ft., From ft. to ft., From ft. to ft.
What is the nearest source of possible contamination:
XXX 1 Septic tank | 2 Sewer lines | 3 Watertight sewer lines | 4 Lateral lines | 5 Cess pool | 6 Seepage pit | 7 Pit privy | 8 Sewage lagoon | 9 Feedyard | 10 Livestock pens | 11 Fuel storage | 12 Fertilizer storage | 13 Insecticide storage | 14 Abandoned water well | 15 Oil well/Gas well | 16 Other (specify below)
Direction from well? West How many feet? 150

FROM	TO	LITHOLOGIC LOG	FROM	TO	LITHOLOGIC LOG
0	2	Topsoil			
2	40	Fine Sand			
40	60	Sandy Clay			
60	118	Fine Sand w/Streak of Clay			
118	230	Sandy Clay			
230	260	Med. to Lar. Sand			
260	320	Sandy Clay w/Strip of Fine Sand			
320	360	Medium Sand			
360	368	Clay, Medium Sand Streaks			

7 CONTRACTOR'S OR LANDOWNER'S CERTIFICATION: This water well was (1) constructed, (2) reconstructed, or (3) plugged under my jurisdiction and was completed on (mo/day/year) Sep. 2, 1981 and this record is true to the best of my knowledge and belief. Kansas Water Well Contractor's License No. 252 This Water Well Record was completed on (mo/day/yr) September 8, 1981 under the business name of Friesen Windmill & Supply Inc. by (signature)

INSTRUCTIONS: Use typewriter or ball point pen, *PLEASE PRESS FIRMLY* and *PRINT* clearly. Please fill in blanks, underline or circle the correct answers. Send top three copies to Kansas Department of Health and Environment, Division of Environment, Environmental Geology Section, Topeka, KS 66620. Send one to WATER WELL OWNER and retain one for your records.

OFFICE USE ONLY T 34 R 35 E/W SEC. 17 SE ¼ SE ¼ SE ¼