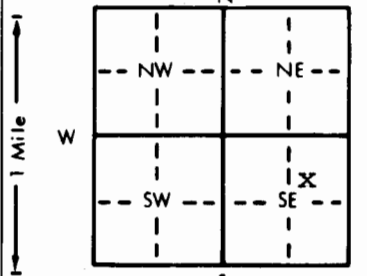
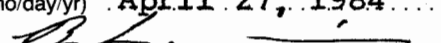


1 LOCATION OF WATER WELL:		Fraction	Section Number	Township Number	Range Number
County: <b>Stevens</b>		<b>SW 1/4 NE 1/4 SE 1/4</b>	<b>25</b>	<b>T 34 S</b>	<b>R 35 E/W</b>
Distance and direction from nearest town or city street address of well if located within city? <b>From Liberal go 5mi West on 2nd Street Road 3mi North 2mi West 1/2mi South and West into location.</b>					
2 WATER WELL OWNER: <b>Cities Service</b>					
RR#, St. Address, Box # : <b>3545 N.W. 58</b>					
City, State, ZIP Code : <b>Oklahoma City, Oklahoma 73112</b>					
Board of Agriculture, Division of Water Resources Application Number: <b>T 84-219</b>					
3 LOCATE WELL'S LOCATION WITH AN "X" IN SECTION BOX:		4 DEPTH OF COMPLETED WELL: <b>280</b> ft. ELEVATION:			
		Depth(s) Groundwater Encountered 1. <b>137</b> ft. 2. ft. 3. ft.			
		WELL'S STATIC WATER LEVEL <b>143</b> ft. below land surface measured on mo/day/yr <b>4/23/84</b>			
		Pump test data: Well water was ft. after hours pumping gpm			
		Est. Yield <b>60</b> gpm: Well water was ft. after hours pumping gpm			
		Bore Hole Diameter <b>9</b> in. to <b>280</b> ft., and in. to ft.			
		WELL WATER TO BE USED AS:			
		5 Public water supply 8 Air conditioning 11 Injection well			
		1 Domestic 3 Feedlot 6 Oil field water supply 9 Dewatering 12 Other (Specify below)			
		2 Irrigation 4 Industrial 7 Lawn and garden only 10 Observation well			
		Was a chemical/bacteriological sample submitted to Department? Yes.....No.....; If yes, mo/day/yr sample was submitted			
		Water Well Disinfected? Yes No			
5 TYPE OF BLANK CASING USED:					
1 Steel 3 RMP (SR) 5 Wrought iron 8 Concrete tile CASING JOINTS: Glued Clamped					
2 PVC 4 ABS 6 Asbestos-Cement 9 Other (specify below) Welded					
7 Fiberglass Threaded					
Blank casing diameter <b>5</b> in. to <b>203</b> ft., Dia in. to ft., Dia in. to ft.					
Casing height above land surface <b>28</b> in., weight <b>2.85</b> lbs./ft. Wall thickness or gauge No. <b>265</b>					
TYPE OF SCREEN OR PERFORATION MATERIAL:					
1 Steel 3 Stainless steel 5 Fiberglass 7 PVC 10 Asbestos-cement					
2 Brass 4 Galvanized steel 6 Concrete tile 8 RMP (SR) 11 Other (specify)					
9 ABS 12 None used (open hole)					
SCREEN OR PERFORATION OPENINGS ARE:					
1 Continuous slot 3 Mill slot 5 Gauzed wrapped 8 Saw cut 11 None (open hole)					
2 Louvered shutter 4 Key punched 6 Wire wrapped 9 Drilled holes					
7 Torch cut 10 Other (specify)					
SCREEN-PERFORATED INTERVALS: From <b>200</b> ft. to <b>280</b> ft. From ft. to ft.					
GRAVEL PACK INTERVALS: From <b>100</b> ft. to <b>280</b> ft. From ft. to ft.					
6 GROUT MATERIAL: 1 Neat cement 2 Cement grout 3 Bentonite 4 Other					
Grout Intervals: From <b>0</b> ft. to <b>10</b> ft. From ft. to ft.					
What is the nearest source of possible contamination:					
1 Septic tank 4 Lateral lines 7 Pit privy 10 Livestock pens 14 Abandoned water well					
2 Sewer lines 5 Cess pool 8 Sewage lagoon 11 Fuel storage 15 Oil well/Gas well					
3 Watertight sewer lines 6 Seepage pit 9 Feedyard 12 Fertilizer storage 16 Other (specify below)					
13 Insecticide storage					
Direction from well? <b>Northeast of water well.</b> How many feet? <b>100'</b>					
FROM	TO	LITHOLOGIC LOG	FROM	TO	LITHOLOGIC LOG
0	2	01 surface			
2	69	04 sandy clay			
69	128	01 clay			
128	143	31 caliche			
143	165	08 medium to large sand			
165	184	31 caliche with gravel			
184	202	01 clay			
202	244	04 sandy clay 60/40			
244	258	07 fine sand			
258	275	04 sandy clay 60/40			
275	280	01 white clay			
7 CONTRACTOR'S OR LANDOWNER'S CERTIFICATION: This water well was (1) constructed, (2) reconstructed, or (3) plugged under my jurisdiction and was completed on (mo/day/year) <b>April 23, 1984</b> and this record is true to the best of my knowledge and belief. Kansas Water Well Contractor's License No. <b>118</b> This Water Well Record was completed on (mo/day/yr) <b>April 27, 1984</b> under the business name of <b>Carlile Water Well Service, Inc.</b> by (signature) 					
INSTRUCTIONS: Use typewriter or ball point pen, PLEASE PRESS FIRMLY and PRINT clearly. Please fill in blanks, underline or circle the correct answers. Send top three copies to Kansas Department of Health and Environment, Division of Environment, Environmental Geology Section, Topeka, KS 66620. Send one to WATER WELL OWNER and retain one for your records.					