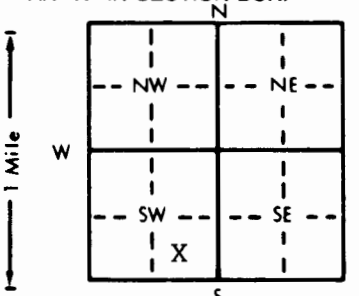


1 LOCATION OF WATER WELL:		Fraction	Section Number	Township Number	Range Number
County: Stevens		1/4 C/SE 1/4 SW 1/4	32	T 34 S	R 35 EW
Distance and direction from nearest town or city street address of well if located within city? 9SW/Woods, KS--					
2 WATER WELL OWNER:		OXY USA, Inc.		#3 Wonder B	
RR#, St. Address, Box # :		Box 26100		Board of Agriculture, Division of Water Resources	
City, State, ZIP Code :		Oklahoma City, OK 73126-0100		Application Number: (OXY permits)	
3 LOCATE WELL'S LOCATION WITH AN "X" IN SECTION BOX:		4 DEPTH OF COMPLETED WELL: 320 ft. ELEVATION:			
		Depth(s) Groundwater Encountered 1. 150 ft. 2. ft. 3. ft.			
		WELL'S STATIC WATER LEVEL 150 ft. below land surface measured on mo/day/yr 2/02/93			
		Pump test data: Well water was 190 ft. after 1 hours pumping 100 gpm			
		Est. Yield 100 gpm: Well water was ft. after hours pumping gpm			
		Bore Hole Diameter 9 1/2 in. to 320 ft., and in. to ft.			
		WELL WATER TO BE USED AS: 5 Public water supply 8 Air conditioning 11 Injection well			
		1 Domestic 3 Feedlot 6 Oil field water supply 9 Dewatering 12 Other (Specify below)			
		2 Irrigation 4 Industrial 7 Lawn and garden only 10 Monitoring well			
		Was a chemical/bacteriological sample submitted to Department? Yes No X; If yes, mo/day/yr sample was submitted			
		Water Well Disinfected? Yes X No			
5 TYPE OF BLANK CASING USED:		5 Wrought iron 8 Concrete tile		CASING JOINTS: Glued X Clamped	
1 Steel 3 RMP (SR)		6 Asbestos-Cement 9 Other (specify below)		Welded	
2 PVC 4 ABS		7 Fiberglass		Threaded	
Blank casing diameter 5 in. to 320 ft., Dia in. to ft., Dia in. to ft.					
Casing height above land surface 24 in., weight 2.902 lbs./ft. Wall thickness or gauge No. 280 SDR21					
TYPE OF SCREEN OR PERFORATION MATERIAL:		7 PVC 10 Asbestos-cement			
1 Steel 3 Stainless steel 5 Fiberglass 8 RMP (SR)		11 Other (specify)			
2 Brass 4 Galvanized steel 6 Concrete tile 9 ABS		12 None used (open hole)			
SCREEN OR PERFORATION OPENINGS ARE:		5 Gauzed wrapped 8 Saw cut 11 None (open hole)			
1 Continuous slot 3 Mill slot 6 Wire wrapped 9 Drilled holes		10 Other (specify)			
2 Louvered shutter 4 Key punched 7 Torch cut					
SCREEN-PERFORATED INTERVALS: From 240 ft. to 320 ft., From ft. to ft.					
GRAVEL PACK INTERVALS: From 120 ft. to 320 ft., From ft. to ft.					
6 GROUT MATERIAL: 1 Neat cement 2 Cement grout 3 Bentonite 4 Other Hole Plug					
Grout Intervals: From 1 ft. to 20 ft., From ft. to ft.					
What is the nearest source of possible contamination:		10 Livestock pens 14 Abandoned water well			
1 Septic tank 4 Lateral lines 7 Pit privy 11 Fuel storage 15 Oil well/Gas well		16 Other (specify below)			
2 Sewer lines 5 Cess pool 8 Sewage lagoon 12 Fertilizer storage					
3 Watertight sewer lines 6 Seepage pit 9 Feedyard 13 Insecticide storage					
Direction from well? West		How many feet? 700			
FROM	TO	LITHOLOGIC LOG	FROM	TO	PLUGGING INTERVALS
0	4	Surface Soil			
4	40	Clay			
40	66	SSandy Clay			
66	78	Clay			
78	84	Sandy Clay			
84	97	Sand			
97	139	Clay			
139	217	Sand & Clay			
217	224	Clay			
224	268	Sand & Clay			
268	275	Clay			
275	315	Sand & Clay			
315	320	Clay & Sand			
7 CONTRACTOR'S OR LANDOWNER'S CERTIFICATION: This water well was (1) constructed, (2) reconstructed, or (3) plugged under my jurisdiction and was completed on (mo/day/year) 2/02/93 and this record is true to the best of my knowledge and belief. Kansas Water Well Contractor's License No. KWWCL-430 This Water Well Record was completed on (mo/day/yr) 2/02/93 under the business name of Howard Drlg. Co. Box 806 Beaver, OK 73932 by (signature) Howard Drlg. Co.					
INSTRUCTIONS: Use typewriter or ball point pen. PLEASE PRESS FIRMLY and PRINT clearly. Please fill in blanks, underline or circle the correct answers. Send top three copies to Kansas Department of Health and Environment, Bureau of Water, Topeka, Kansas 66620-0001. Telephone: 913-296-5545. Send one to WATER WELL OWNER and retain one for your records.					