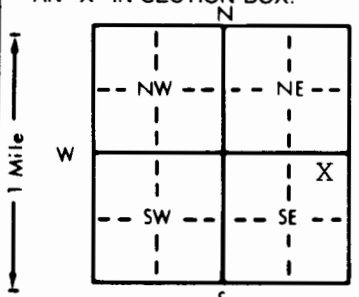


1 LOCATION OF WATER WELL: County: STEVENS Fraction: NE 1/4 NE 1/4 SE 1/4 Section Number: 19 Township Number: T 34 S Range Number: R 36 E/W

Distance and direction from nearest town or city street address of well if located within city?
ONE-HALF (1/2) MILE NORTH FROM ROAD F & 17 ~~XXXX~~ INTERSECTION.

2 WATER WELL OWNER: WADE D. GREENWOOD
 RR#, St. Address, Box #: 1500 S. MONROE STREET Board of Agriculture, Division of Water Resources
 City, State, ZIP Code: HUGOTON, KS 67951 Application Number: 41,907

3 LOCATE WELL'S LOCATION WITH AN "X" IN SECTION BOX:  4 DEPTH OF COMPLETED WELL: XXX 655 ft. ELEVATION: _____
 Depth(s) Groundwater Encountered 1. _____ ft. 2. _____ ft. 3. _____ ft.
 WELL'S STATIC WATER LEVEL 196 ft. below land surface measured on mo/day/yr 4/11/96
 Pump test data: Well water was _____ ft. after _____ hours pumping _____ gpm
 Est. Yield _____ gpm: Well water was _____ ft. after _____ hours pumping _____ gpm
 Bore Hole Diameter 26 in. to 655 ft., and _____ in. to _____ ft.
 WELL WATER TO BE USED AS:
 5 Public water supply 8 Air conditioning 11 Injection well
 1 Domestic 3 Feedlot 6 Oil field water supply 9 Dewatering 12 Other (Specify below)
 Irrigation 4 Industrial 7 Lawn and garden only 10 Monitoring well
 Was a chemical/bacteriological sample submitted to Department? Yes _____ No X; If yes, mo/day/yr sample was submitted _____
 Water Well Disinfected? Yes _____ No _____

5 TYPE OF BLANK CASING USED:
 Steel 3 RMP (SR) 5 Wrought iron 8 Concrete tile CASING JOINTS: Glued _____ Clamped _____
 2 PVC 4 ABS 6 Asbestos-Cement 9 Other (specify below) Welded X
 7 Fiberglass Threaded _____
 Blank casing diameter 16 in. to 655 ft., Dia _____ in. to _____ ft., Dia _____ in. to _____ ft.
 Casing height above land surface 12 in., weight 42.5 lbs./ft. Wall thickness or gauge No. 250
 TYPE OF SCREEN OR PERFORATION MATERIAL:
 Steel 3 Stainless steel 5 Fiberglass 7 PVC 10 Asbestos-cement
 2 Brass 4 Galvanized steel 6 Concrete tile 8 RMP (SR) 11 Other (specify) _____
 12 None used (open hole)
 SCREEN OR PERFORATION OPENINGS ARE:
 1 Continuous slot Mill slot 5 Gauzed wrapped 8 Saw cut 11 None (open hole)
 2 Louvered shutter 4 Key punched 6 Wire wrapped 9 Drilled holes
 7 Torch cut 10 Other (specify) _____
 SCREEN-PERFORATED INTERVALS: From SCREEN 395 ft. to 445 ft., From PERF. 445 ft. to 555 ft.
 From SCREEN 555 ft. to 575 ft., From PERF. 575 ft. to 610 ft.
 GRAVEL PACK INTERVALS: From 20 ft. to 655 ft., From SCREEN 610 ft. to 640 ft.
 From _____ ft. to _____ ft., From PERF. 640 ft. to 655 ft.

6 GROUT MATERIAL: Neat cement 2 Cement grout 3 Bentonite 4 Other _____
 Grout Intervals: From 0 ft. to 20 ft., From _____ ft. to _____ ft., From _____ ft. to _____ ft.
 What is the nearest source of possible contamination:
 1 Septic tank 4 Lateral lines 7 Pit privy 10 Livestock pens 14 Abandoned water well
 2 Sewer lines 5 Cess pool 8 Sewage lagoon 11 Fuel storage 15 Oil well/Gas well
 3 Watertight sewer lines 6 Seepage pit 9 Feedyard 12 Fertilizer storage Other (specify below)
CROPLAND-NOTHING IMMEDIATE VICINITY.
 13 Insecticide storage
 Direction from well? _____ How many feet? _____

FROM	TO	LITHOLOGIC LOG	FROM	TO	PLUGGING INTERVALS
0	200	SURFACE, SAND & CLAY			
200	260	FINE SAND W/CLAY STREAKS			
260	410	CLAY W/FINE SAND STREAKS			
410	550	GRAY CLAY W/FINE TO MED. SAND			
550	650	FINE TO MED SAND W/CLAY STREAKS			
650	680	RED BED			

7 CONTRACTOR'S OR LANDOWNER'S CERTIFICATION: This water well was constructed, (2) reconstructed, or (3) plugged under my jurisdiction and was completed on (mo/day/year) 4/11/96 and this record is true to the best of my knowledge and belief. Kansas Water Well Contractor's License No. 225 This Water Well Record was completed on (mo/day/yr) 6/15/96 under the business name of KIM DRILLING, INC. by (signature) 