


1 LOCATION OF WATER WELL: Fraction : Section Number : Township Number : Range Number
 COUNTY: 095 STEVENS : NW 1/4 NE 1/4 NE 1/4 : 22 : T 34 S : R 36 W

Distance and direction from nearest town or city street address of well if located within city?
 APPROX. 7 MILES EAST, 6 MILES SOUTH AND 1/4 WEST OF HUGOTON

2 WATER WELL OWNER: WHEELER, LEWIS
 RR#, St. Address, Box #: R R 1, BOX 69 Board of Agriculture, Division of Water Resources

City, State, ZIP code : HUGOTON, KS 67591- Application Number: 42116 & 42217

3 LOCATE WELL'S LOCATION WITH AN "X" IN SECTION BOX: 4 DEPTH OF COMPLETED WELL 676 ELEVATION: 0
 Depth(s) Groundwater Encountered 1. 0 ft. 2. 0 ft. 3. 0 ft.

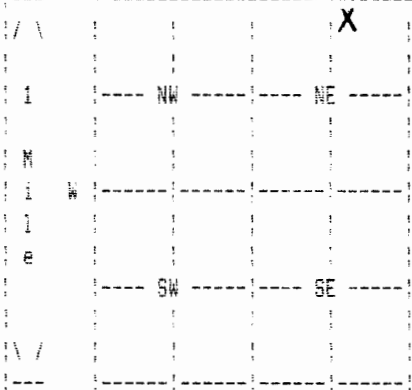

WELL'S STATIC WATER LEVEL 204 ft. below land surface measured on mo/day/yr 05/20/97
 Pump testdata: Well water was 251 ft. after 4 hours pumping 1410 gpm
 Estimated Yield 1410 gpm: Well water was 0 ft. after 0 hours pumping 0 gpm
 Bore Hole Diameter 24 in. to 676 ft., and in. to 0 ft.

WELL WATER TO BE USED AS: 02 IRRIGATION
 Was a chemical/bacteriological sample submitted to department? No :
 If yes, mo/day/yr sample was submitted Water well disinfected? Yes

5 TYPE OF BLANK CASING USED: 01 STEEL CASING JOINTS: WELDED
 Blank casing diameter 16 in. to 676 ft., Dia in. to 0 ft., Dia in. to 0 ft.
 Casing height above land surface 12 in., weight 42 lbs/ft. Wall thickness or gauge No. .250
 TYPE OF SCREEN OR PERFORATION MATERIAL: 01 STEEL
 SCREEN OR PERFORATION OPENINGS ARE: 01 CONT. SLOT

SCREEN PERFORATED INTERVALS: From 274 ft. to 354 ft., From 0 ft. to 0 ft.
 From 413 ft. to 673 ft., From 0 ft. to 0 ft.
 GRAVEL PACK INTERVALS: From 20 ft. to 520 ft., From 0 ft. to 0 ft.
 From 520 ft. to 676 ft., From 0 ft. to 0 ft.

6 GROUT MATERIAL 03 BENTONITE
 Grout intervals: From 0 ft. to 20 ft., From 0 ft. to 0 ft., From 0 ft. to 0 ft.
 What is the nearest source of possible contamination: NONE OBSERVED
 Direction from well? How many feet? 0

FROM	TO	LITHOLOGIC LOG	FROM	TO	PLUGGING INTERVALS
0	200	02 SILT 05 SAND 01 CLAY			
200	220	01 CLAY 05 SAND			
220	240	01 CLAY 07 FINE SAND			
240	260	07 FINE SAND 01 CLAY			
260	280	04 SANDY CLAY 07 FINE SAND 01 CLAY			
280	320	07 FINE SAND 08 MEDIUM SAND 01 CLAY			
320	340	07 FINE SAND 01 CLAY			
340	360	05 SAND 13 FINE GRAVEL 01 CLAY			
360	400	01 CLAY 05 SAND			
400	420	01 CLAY 07 FINE SAND			

7 CONTRACTOR'S OR LANDOWNER'S CERTIFICATION: This water well was Constructed under my jurisdiction and was completed on (mo/day/year) 05/15/97 and this record is true to the best of my knowledge and belief. Kansas Water Well Contractor's License No. 145 This Water Well Record was completed on (mo/day/yr) 06/06/97 under the business name of HENKLE DRILLING & SUPPLY by (signature)

1 LOCATION OF WATER WELL: Fraction Section Number Township Number Range Number
 COUNTY: 095 STEVENS NW 1/4 NE 1/4 NE 1/4 22 T 34 S R 36 W

2 WATER WELL OWNER: WHEELER, LEWIS
 RR#, St. Address, Box #: R R 1, BOX 69 Board of Agriculture, Division of Water Resources
 City, State, ZIP code : HUGOTON, KS 67591- Application Number:

FROM	TO	LITHOLOGIC LOG
420	440	07 FINE SAND 01 CLAY
440	460	07 FINE SAND 08 MEDIUM SAND 01 CLAY
460	520	07 FINE SAND 08 MEDIUM SAND 01 CLAY
520	580	08 MEDIUM SAND 09 COARSE SAND 01 CLAY
580	640	07 FINE SAND 08 MEDIUM SAND 01 CLAY
640	660	01 CLAY 07 FINE SAND 08 MEDIUM SAND
660	680	01 CLAY 05 SAND

7 CONTRACTOR'S OR LANDOWNER'S CERTIFICATION: This water well was Constructed under my jurisdiction and was completed on (mo/day/year) 05/15/97 and this record is true to the best of my knowledge and belief. Kansas Water Well Contractor's License No. 145 This Water Well Record was completed on (mo/day/yr) 06/06/97 under the business name of HENKLE DRILLING & SUPPLY by (signature) *Benny Reichert*