


## WATER WELL RECORD Form WWC-5 KSA 82a-1212

1 LOCATION OF WATER WELL:	Fraction	Section Number	Township Number	Range Number
COUNTY: 095 STEVENS	SW 1/4 NW 1/4 SE 1/4	36	T 34 S	R 36 W

Distance and direction from nearest town or city street address of well if located within city?  
 FROM HUGOTON; APPX 8 3/4 MILES SOUTH & 8 3/4 MILES EAST

2 WATER WELL OWNER: ROEHR PARTNERS  
 RR#, St. Address, Box # : 2421 S. HOLLY RD Board of Agriculture, Division of Water Resources  
 City, State, ZIP code : LIBERAL, KS 67901-2087 Application Number: 14,858

3 LOCATE WELL'S LOCATION WITH  
 AN "X" IN SECTION BOX:

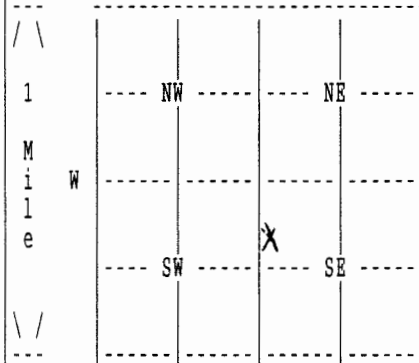

4 DEPTH OF COMPLETED WELL 599 ELEVATION: 0  
 Depth(s) Groundwater Encountered 1. 0 ft. 2. 0 ft. 3. 0 ft.

WELL'S STATIC WATER LEVEL 188 ft. below land surface measured on mo/day/yr 12/04/04  
 Pump test data: Well water was 302 ft. after 4 hours pumping 1400 gpm

Estimated Yield 0 gpm: Well water was 0 ft. after 0 hours pumping 0 gpm

Bore Hole Diameter 24 in. to 599 ft., and in. to 0 ft.

WELL WATER TO BE USED AS: 02 IRRIGATION

Was a chemical/bacteriological sample submitted to department? No ;  
 If yes, mo/day/yr sample was submitted Water well disinfected? Yes

5 TYPE OF BLANK CASING USED: 01 STEEL CASING JOINTS: WELDED  
 Blank casing diameter 16 in. to 599 ft., Dia in. to 0 ft., Dia in. to 0 ft.  
 Casing height above land surface 12 in., weight 42 lbs/ft. Wall thickness or gauge No. .250  
 TYPE OF SCREEN OR PERFORATION MATERIAL: 01 STEEL  
 SCREEN OR PERFORATION OPENINGS ARE: 01 CONT. SLOT

SCREEN PERFORATED INTERVALS:	From 297 ft. to 397 ft.,	From 0 ft. to 0 ft.
	From 504 ft. to 594 ft.,	From 0 ft. to 0 ft.
GRAVEL PACK INTERVALS:	From 20 ft. to 599 ft.,	From 0 ft. to 0 ft.
	From 0 ft. to 0 ft.,	From 0 ft. to 0 ft.

6 GROUT MATERIAL 03 BENTONITE  
 Grout Intervals: From 0 ft. to 20 ft., From 0 ft. to 0 ft., From 0 ft. to 0 ft.  
 What is the nearest source of possible contamination: 14 ABAND. WELL  
 Direction from well? SOUTH How many feet? 290

FROM	TO	LITHOLOGIC LOG	FROM	TO	PLUGGING INTERVALS
0	3	02 SILT			
3	26	01 CLAY 31 CALICHE 05 SAND			
26	34	07 FINE SAND 01 CLAY			
34	40	01 CLAY			
40	60	07 FINE SAND 01 CLAY			
60	93	01 CLAY 20 LIMESTONE			
93	99	07 FINE SAND 08 MEDIUM SAND			
99	119	01 CLAY			
119	133	07 FINE SAND 08 MEDIUM SAND			
133	195	01 CLAY 20 LIMESTONE 05 SAND			

7 CONTRACTOR'S OR LANDOWNER'S CERTIFICATION: This water well was Constructed under my jurisdiction and was completed on (mo/day/year) 12/01/04 and this record is true to the best of my knowledge and belief. Kansas  
 Water Well Contractor's License No. 145 This Water Well Record was completed on (mo/day/yr) 03/11/05  
 under the business name of HENKLE DRILLING & SUPPLY by (signature)

(Continued)

WATER WELL RECORD Form WWC-5 KSA 82a-1212

1 LOCATION OF WATER WELL: COUNTY: 095 STEVENS	Fraction SW 1/4 NW 1/4 SE 1/4	Section Number 36	Township Number T 34 S	Range Number R 36 W
--	----------------------------------	----------------------	---------------------------	------------------------

2 WATER WELL OWNER: RR#, St. Address, Box # : 2421 S. HOLLY RD City, State, ZIP code : LIBERAL, KS 67901-2087	ROEHR PARTNERS Board of Agriculture, Division of Water Resources Application Number: 14,858
---	---

FROM	TO	LITHOLOGIC LOG
195	211	07 FINE SAND 01 CLAY
211	244	05 SAND 01 CLAY
244	274	01 CLAY 20 LIMESTONE
274	300	07 FINE SAND 01 CLAY
300	320	05 SAND 01 CLAY
320	358	05 SAND 01 CLAY
358	364	01 CLAY
364	384	07 FINE SAND 08 MEDIUM SAND 01 CLAY
384	397	07 FINE SAND 01 CLAY
397	448	01 CLAY 20 LIMESTONE
448	460	01 CLAY 20 LIMESTONE 05 SAND
460	504	01 CLAY 20 LIMESTONE 05 SAND
504	524	05 SAND 13 FINE GRAVEL 28 ROCK
524	548	05 SAND 13 FINE GRAVEL 28 ROCK
548	559	05 SAND 01 CLAY
559	565	01 CLAY
565	580	05 SAND 13 FINE GRAVEL 28 ROCK
580	594	05 SAND 13 FINE GRAVEL 28 ROCK
594	595	20 LIMESTONE

7 CONTRACTOR'S OR LANDOWNER'S CERTIFICATION: This water well was Constructed under my jurisdiction and was completed on (mo/day/year) 12/01/04 and this record is true to the best of my knowledge and belief. Kansas Water Well Contractor's License No. 145 This Water Well Record was completed on (mo/day/yr) 03/11/05 under the business name of HENKLE DRILLING & SUPPLY by (signature) 