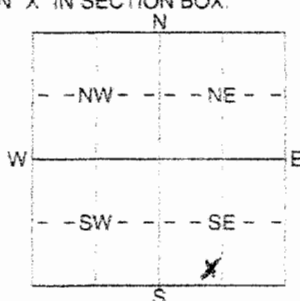


1 LOCATION OF WATER WELL: Fraction SE 1/4 SW 1/4 SE 1/4 Section Number 8 Township Number T 34 S Range Number R 36 E/W
 County: Stevens

Distance and direction from nearest town or city street address of well if located within city?

5 West 4 3/4 South of Hughton

2 WATER WELL OWNER: Gerardo Perez
 RR#, St. Address, Box # : Hughton, KS 67951
 City, State, ZIP Code :
 Board of Agriculture, Division of Water Resources
 Application Number:

3 LOCATE WELL'S LOCATION WITH: 4 DEPTH OF COMPLETED WELL 550 ft. ELEVATION:
 AN "X" IN SECTION BOX:

 Depth(s) Groundwater Encountered 1 190 ft. 2 190 ft. 3 190 ft.
 WELL'S STATIC WATER LEVEL 190 ft. below land surface measured on mo/day/yr 7-28-06
 WELL WATER TO BE USED AS:
 1 Domestic 3 Feedlot 6 Oil field water supply 9 Dewatering 12 Other (Specify below)
 2 Irrigation 4 Industrial 7 Domestic (lawn & garden) 10 Monitoring well
 Was a chemical/bacteriological sample submitted to Department? Yes No X If yes, mo/day/yr sample was submitted
 Water Well Disinfected? Yes No

5 TYPE OF BLANK CASING USED:
 1 Steel 3 RMP (SR) 5 Wrought iron 8 Concrete tile CASING JOINTS: Glued Clamped
 2 PVC 4 ABS 6 Asbestos-Cement 9 Other (specify below) Welded
 7 Fiberglass 6025-126 Threaded
 Casing height above land surface 24 in. weight lbs. Wall thickness or gauge No. SDR 21
 TYPE OF SCREEN OR PERFORATION MATERIAL:
 1 Steel 3 Stainless Steel 5 Fiberglass 7 PVC 10 Asbestos-Cement
 2 Brass 4 Galvanized Steel 6 Concrete tile 8 RMP (SR) 11 Other (Specify)
 9 ABS 12 None used (open hole)
 SCREEN OR PERFORATION OPENINGS ARE:
 1 Continuous slot 3 Mill slot 5 Guaged wrapped 8 Saw cut 11 None (open hole)
 2 Louvered shutter 4 Key punched 6 Wire wrapped 9 Drilled holes
 7 Torch cut 10 Other (specify) ft.

6 GROUT MATERIAL: 1 Neat cement 2 Cement grout 3 Bentonite 4 Other
 Grout intervals: From 7 ft. to 27 ft. From 27 ft. to 550 ft. From 550 ft. to 550 ft. From 550 ft. to 550 ft.
 What is the nearest source of possible contamination:
 1 Septic tank 4 Lateral lines 7 Pit privy 10 Livestock pens 14 Abandoned water well
 2 Sewer lines 5 Cess pool 8 Sewage lagoon 11 Fuel storage 15 Oil well/Gas well
 3 Watertight sewer lines 6 Seepage pit 9 Feedyard 12 Fertilizer storage 16 Other (specify below)
none observed
 Direction from well? How many feet?

FROM	TO	LITHOLOGIC LOG	FROM	TO	PLUGGING INTERVALS
0	7	Topsoil			
7	60	Brown sandy clay			
60	140	fine to med sand			
140	190	clay, caliche & a little sand			
190	230	fine to med sand			
230	240	clay & caliche			
240	267	sandy clay			
267	300	fine to med sand			
300	535	BRN sandy CL & a few sand streaks			
535	550	fine to med sand & sandy CL			

7 CONTRACTOR'S OR LANDOWNER'S CERTIFICATION: This water well was (1) constructed, (2) reconstructed, or (3) plugged under my jurisdiction and was completed on (mo/day/year) 7-28-06 and this record is true to the best of my knowledge and belief. Kansas
 Water Well Contractor's Licence No 473 This Water Well Record was completed on (mo/day/yr) 7-29-06
 under the business name of Tyler Water Well Inc by (signature) Dan Zbor