


1 LOCATION OF WATER WELL: Fraction Section Number Township Number Range Number
 COUNTY: 095 STEVENS SW 1/4 SW 1/4 NW 1/4 15 T 34 S R 36 W

Distance and direction from nearest town or city street address of well if located within city?
 APPROX. 6 MILES EAST, & 5 1/2 MILES SOUTH OF HUGOTON

2 WATER WELL OWNER: DAVIS TRUST, RBT & DORRTON Board of Agriculture, Division of Water Resources
 RR#, St. Address, Box #: PO BOX 47428
 City, State, ZIP code: WICHITA, KS 67201-7428 Application Number: 43,283

3 LOCATE WELL'S LOCATION WITH AN "X" IN SECTION BOX:

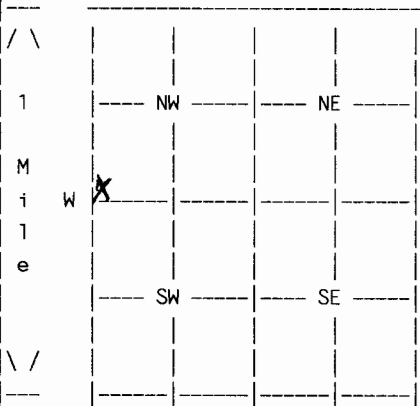

4 DEPTH OF COMPLETED WELL 653 ELEVATION: 0
 Depth(s) Groundwater Encountered 1. 0 ft. 2. 0 ft. 3. 0 ft.
 WELL'S STATIC WATER LEVEL 0 ft. below land surface measured on mo/day/yr
 Pump test data: Well water was 0 ft. after 0 hours pumping 0 gpm
 Estimated Yield 0 gpm: Well water was 0 ft. after 0 hours pumping 0 gpm
 Bore Hole Diameter 24 in. to 653 ft., and in. to 0 ft.
 WELL WATER TO BE USED AS: 02 IRRIGATION
 Was a chemical/bacteriological sample submitted to department? No;
 If yes, mo/day/yr sample was submitted Water well disinfected? Yes

5 TYPE OF BLANK CASING USED: 01 STEEL CASING JOINTS: WELDED
 Blank casing diameter 16 in. to 653 ft., Dia in. to 0 ft., Dia in. to 0 ft.
 Casing height above land surface 12 in., weight 42 lbs/ft. Wall thickness or gauge No. .250
 TYPE OF SCREEN OR PERFORATION MATERIAL: 01 STEEL
 SCREEN OR PERFORATION OPENINGS ARE: 01 CONT. SLOT

SCREEN PERFORATED INTERVALS: From 281 ft. to 441 ft., From 528 ft. to 648 ft.
 From 473 ft. to 483 ft., From 0 ft. to 0 ft.
 GRAVEL PACK INTERVALS: From 20 ft. to 550 ft., From 0 ft. to 0 ft.
 From 550 ft. to 653 ft., From 0 ft. to 0 ft.

6 GROUT MATERIAL 03 BENTONITE
 Grout Intervals: From 0 ft. to 20 ft., From 0 ft. to 0 ft., From 0 ft. to 0 ft.
 What is the nearest source of possible contamination: NONE OBSERVED
 Direction from well? How many feet? 0

FROM	TO	LITHOLOGIC LOG	FROM	TO	PLUGGING INTERVALS
0	1	05 SAND			
1	5	07 FINE SAND			
5	10	04 SANDY CLAY 31 CALICHE 05 SAND			
10	27	07 FINE SAND 01 CLAY			
27	50	01 CLAY 31 CALICHE			
50	64	01 CLAY			
64	100	05 SAND 01 CLAY			
100	121	05 SAND 11 GRAVEL 28 ROCK			
121	160	01 CLAY 20 LIMESTONE 05 SAND			
160	200	04 SANDY CLAY 05 SAND 20 LIMESTONE			

7 CONTRACTOR'S OR LANDOWNER'S CERTIFICATION: This water well was Constructed under my jurisdiction and was completed on (mo/day/year) 06/25/98 and this record is true to the best of my knowledge and belief. Kansas Water Well Contractor's License No. 145 This Water Well Record was completed on (mo/day/yr) 07/24/98 under the business name of HENKLE DRILLING & SUPPLY by (signature)

1 LOCATION OF WATER WELL:	Fraction	Section Number	Township Number	Range Number
COUNTY: 095 STEVENS	SW 1/4 SW 1/4 NW 1/4	15	T 34 S	R 36 W

2 WATER WELL OWNER: DAVIS TRUST, RBT & DORRTON
 RR#, St. Address, Box #: PO BOX 47428 Board of Agriculture, Division of Water Resources

City, State, ZIP code : WICHITA, KS 67201-7428 Application Number: 43,283

FROM	TO	LITHOLOGIC LOG
200	216	04 SANDY CLAY 20 LIMESTONE 05 SAND
216	240	01 CLAY 05 SAND 20 LIMESTONE
240	251	07 FINE SAND 08 MEDIUM SAND 01 CLAY
250	257	04 SANDY CLAY
257	270	05 SAND 01 CLAY
270	275	01 CLAY 20 LIMESTONE
275	288	05 SAND 11 GRAVEL 01 CLAY
288	441	05 SAND 01 CLAY
441	466	01 CLAY 05 SAND 20 LIMESTONE
466	480	05 SAND
480	530	01 CLAY 05 SAND
530	540	05 SAND 01 CLAY
540	553	01 CLAY 05 SAND
553	562	05 SAND
562	603	07 FINE SAND 08 MEDIUM SAND 01 CLAY
603	630	05 SAND 11 GRAVEL 01 CLAY
630	639	05 SAND 11 GRAVEL 30 ROCK & CLAY
639	648	28 ROCK
648	687	01 CLAY 20 LIMESTONE 05 SAND
687	700	19 SHALE

7 CONTRACTOR'S OR LANDOWNER'S CERTIFICATION: This water well was Constructed under my jurisdiction and was completed on (mo/day/year) 06/25/98 and this record is true to the best of my knowledge and belief. Kansas Water Well Contractor's License No. 145 This Water Well Record was completed on (mo/day/yr) 07/24/98 under the business name of HENKLE DRILLING & SUPPLY by (signature) *Bruce Richman*