USE TYPEWRITER OR BALL POINT PEN-PRESS FIRMLY, PRINT CLEARLY.

WATER WELL RECORD
KSA 82a-1201-1215

Kansas Department of Health and Environment-Division of Environment
(Water well Contractors)
Topeka, Kansas 66620

1. Location of well:	County	Fraction	Section number	Township number	Range number
	Stevens	SW 1/4 NE 1/4 NE 1/4	10	T 34 S	R 36 E/W

2. Distance and direction from nearest town or city: 7 miles EAST 4 1/4 South of Hugoton, KAN
Street address of well location if in city:

3. Owner of well: CARMELITA GILBERT
R.R. or street: 6745 Garrison
City, state, zip code: Arvada, Colorado 80004

4. Locate with "X" in section below: Sketch map:

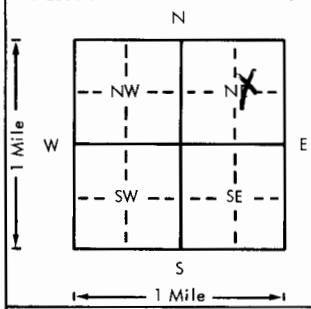

6. Bore hole dia 26 in. Completion date 11-20-78
Well depth 627 ft.

7. __ Cable tool X Rotary __ Driven __ Dug
__ Hollow rod __ Jetted __ Bored __ Reverse rotary

8. Use: __ Domestic __ Public supply __ Industry
X Irrigation __ Air conditioning __ Stock
__ Lawn __ Oil field water __ Other

9. Casing: Material Steel Height: Above or below
Threaded ___ Welded X Surface 12 in.
RMP ___ PVC ___ Weight 42.5 lbs./ft.
Dia. 16 in. to 627 ft. depth Wall Thickness: inches or
Dia. ___ in. to ___ ft. depth gage No. .250

5. Type and color of material	From	To
Top soil	0	260
Med sand clay & rock streak	260	340
Med coarse sand & clay streak	340	400
Med sand & clay streaks w/rock streak	400	500
Med sand w/clay streaks	500	560
Med coarse sand & clay streak & rock	560	625
Blue clay & rock	625	700

(Use a second sheet if needed)

10. Screen: Manufacturer's name
Type Steel Dia. 16
Slot/gauze 1/8 Length 3
Set between 261 ft. and 380 ft.
400 600 580 627 ft.
Gravel pack? X Size range of material 1/8-1/4

11. Static water level:
148 ft. below land surface Date (mo./day/yr.) 11-22-78

12. Pumping level below land surfaces: NA
___ ft. after ___ hrs. pumping ___ g.p.m.
___ ft. after ___ hrs. pumping ___ g.p.m.
Estimated maximum yield ___ g.p.m.

13. Water sample submitted: mo./day/yr.
___ Yes X No Date

14. Well head completion:
___ Pitless adapter ___ Inches above grade

15. Well grouted? ___
With: X Neat cement ___ Bentonite ___ Concrete
Depth: From 0 ft. to 10 ft.

16. Nearest source of possible contamination:
ft. ___ Direction ___ Type ___
Well disinfected upon completion? ___ Yes X No

17. Pump: X Not installed
Manufacturer's name
Model number ___ HP ___ Volts ___
Length of drop pipe ___ ft. capacity ___ g.p.m.
Type:
___ Submersible ___ Turbine
___ Jet ___ Reciprocating
___ Centrifugal ___ Other

18. Elevation:
Topography:
___ Hill
___ Slope
___ Upland
___ Valley

19. Remarks:
Screen 380'-400'
580'-600'
16. Cropland

20. Water well contractor's certification:
This well was drilled under my jurisdiction and this report is true to the best of my knowledge and belief.
KTM DRILLING, INC. 225
Business name License No.
Address Box 1385, Guymon, OK
Signed [signature] Date 1/10/79
Authorized representative

T 34 R 36 E Sec 10 1/4 1/4 1/4 SWNENE

Forward the white, blue and pink copies to the Department of Health and Environment

Form WWC-5