


1 LOCATION OF WATER WELL: County: **Stevens** Fraction: $\frac{1}{4}$ **center** $\frac{1}{4}$ **SW** Section Number: **10** Township Number: **T 34 S** Range Number: **R 36 EW**

Distance and direction from nearest town or city street address of well if located within city?
From 2nd Street road and Moscow road North to 5 Mile Road West $\frac{1}{2}$ North into

2 WATER WELL OWNER: **Wheeler 1-10 Ensign Operating**
 RR#, St. Address, Box # : **621 17th Street**
 City, State, ZIP Code : **Denver, CO 80293**
 Board of Agriculture, Division of Water Resources
 Application Number: **910249**

3 LOCATE WELL'S LOCATION WITH AN "X" IN SECTION BOX:

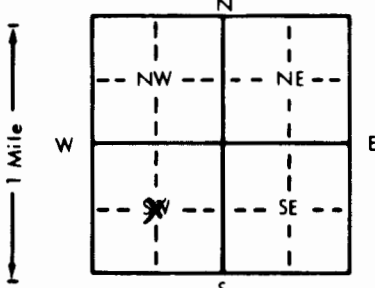

4 DEPTH OF COMPLETED WELL: **320** ft. ELEVATION:
 Depth(s) Groundwater Encountered 1. **130** ft. 2. _____ ft. 3. _____ ft.
 WELL'S STATIC WATER LEVEL **190** ft. below land surface measured on mo/day/yr **6-5-91**
 Pump test data: Well water was **185** ft. after **2** hours pumping **90** gpm
 Est. Yield **100** gpm: Well water was _____ ft. after _____ hours pumping _____ gpm
 Bore Hole Diameter **9** in. to **320** ft., and _____ in. to _____ ft.

WELL WATER TO BE USED AS:
 5 Public water supply 8 Air conditioning 11 Injection well
 1 Domestic 3 Feedlot 6 Oil field water supply 9 Dewatering 12 Other (Specify below)
 2 Irrigation 4 Industrial 7 Lawn and garden only 10 Monitoring well
 Was a chemical/bacteriological sample submitted to Department? Yes _____ No
 Water Well Disinfected? Yes No

5 TYPE OF BLANK CASING USED:
 1 Steel 3 RMP (SR) 5 Wrought iron 8 Concrete tile CASING JOINTS: Glued Clamped _____
 2 PVC 4 ABS 6 Asbestos-Cement 9 Other (specify below) Welded _____
 7 Fiberglass Threaded _____

Blank casing diameter **5** in. to **220** ft., Dia _____ in. to _____ ft., Dia _____ in. to _____ ft.
 Casing height above land surface **14** in., weight **200** lbs./ft. Wall thickness or gauge No. **0.265**

TYPE OF SCREEN OR PERFORATION MATERIAL:
 1 Steel 3 Stainless steel 5 Fiberglass 8 RMP (SR) 10 Asbestos-cement 11 Other (specify) _____
 2 Brass 4 Galvanized steel 6 Concrete tile 9 ABS 12 None used (open hole)

SCREEN OR PERFORATION OPENINGS ARE:
 1 Continuous slot 3 Mill slot 5 Gauzed wrapped 8 Saw cut 11 None (open hole)
 2 Louvered shutter 4 Key punched 6 Wire wrapped 9 Drilled holes
 7 Torch cut 10 Other (specify) _____

SCREEN-PERFORATED INTERVALS: From **180** ft. to **220** ft. to _____ ft. to _____ ft.
 From _____ ft. to _____ ft. to _____ ft. to _____ ft.
 GRAVEL PACK INTERVALS: From **180** ft. to **320** ft. to _____ ft. to _____ ft.
 From _____ ft. to _____ ft. to _____ ft. to _____ ft.

6 GROUT MATERIAL: 1 Neat cement 2 Cement grout 3 Bentonite 4 Other _____
 Grout Intervals: From **0** ft. to **20** ft. to _____ ft. to _____ ft. to _____ ft. to _____ ft.

What is the nearest source of possible contamination:
 1 Septic tank 4 Lateral lines 7 Pit privy 10 Livestock pens 14 Abandoned water well
 2 Sewer lines 5 Cess pool 8 Sewage lagoon 11 Fuel storage 15 Oil well/Gas well
 3 Watertight sewer lines 6 Seepage pit 9 Feedyard 12 Fertilizer storage 16 Other (specify below)
 13 Insecticide storage _____
 Direction from well? **South** How many feet? **350**

FROM	TO	LITHOLOGIC LOG	FROM	TO	PLUGGING INTERVALS
0	190	Overburden			
190	220	Fine and medium sand and clay streaks			
220	240	Fine sand and clay			
240	260	Fine sand and clay			
260	280	Fine sand and clay streaks			
280	300	Fine sand, clay streaks and rock			
300	320	Fine sand and blue clay streaks			

7 CONTRACTOR'S OR LANDOWNER'S CERTIFICATION: This water well was (1) constructed, (2) reconstructed, or (3) plugged under my jurisdiction and was completed on (mo/day/year) **6-5-91** and this record is true to the best of my knowledge and belief. Kansas Water Well Contractor's License No. **142** This Water Well Record was completed on (mo/day/yr) **6-10-91** under the business name of **T & W Water Well Service, Inc.** by (signature) *E.D. Waggoner*