


1 LOCATION OF WATER WELL: County: Stevens Fraction: SE 1/4 SE 1/4 SW 1/4 Section Number: 111 Township Number: T 34 Z S Range Number: R 36 E/W

Distance and direction from nearest town or city street address of well if located within city?  
7 East, 5 South, 1/2 East of Hugoton, Kansas

2 WATER WELL OWNER: Mr. Lewis Wheeler  
 RR#, St. Address, Box #: R.F.D. Board of Agriculture, Division of Water Resources  
 City, State, ZIP Code: Hugoton, Kansas 67951 Application Number: ---

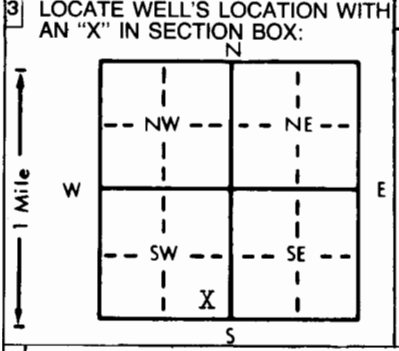

4 DEPTH OF COMPLETED WELL: 526 ft. ELEVATION: Upland  
 Depth(s) Groundwater Encountered 1. 200 ft. 2. 400 ft. 3. 455 ft.  
 WELL'S STATIC WATER LEVEL 200 ft. below land surface measured on mo/day/yr July 20, 1983  
 Pump test data: Well water was \_\_\_\_\_ ft. after \_\_\_\_\_ hours pumping \_\_\_\_\_ gpm  
 Est. Yield 50+ gpm: Well water was \_\_\_\_\_ ft. after \_\_\_\_\_ hours pumping \_\_\_\_\_ gpm  
 Bore Hole Diameter: 9.7/8 in. to 526 ft., and \_\_\_\_\_ in. to \_\_\_\_\_ ft.  
 WELL WATER TO BE USED AS:  
 Domestic 3 Feedlot 6 Oil field water supply 9 Dewatering 12 Other (Specify below)  
 2 Irrigation 4 Industrial 7 Lawn and garden only 10 Observation well  
 Was a chemical/bacteriological sample submitted to Department? Yes \_\_\_\_\_ No XX; If yes, mo/day/yr sample was submitted \_\_\_\_\_  
 Water Well Disinfected? Yes XX No \_\_\_\_\_

5 TYPE OF BLANK CASING USED:  
 1 Steel 3 RMP (SR) 5 Wrought iron 8 Concrete tile CASING JOINTS: Glued XX Clamped \_\_\_\_\_  
 PVC 4 ABS 6 Asbestos-Cement 9 Other (specify below) Welded \_\_\_\_\_  
 7 Fiberglass \_\_\_\_\_ Threaded \_\_\_\_\_  
 Blank casing diameter 5 in. to 426 ft., Dia \_\_\_\_\_ in. to \_\_\_\_\_ ft., Dia \_\_\_\_\_ in. to \_\_\_\_\_ ft.  
 Casing height above land surface 12 in., weight 3.92 lbs./ft. Wall thickness or gauge No. 375  
 TYPE OF SCREEN OR PERFORATION MATERIAL:  PVC 10 Asbestos-cement  
 1 Steel 3 Stainless steel 5 Fiberglass 8 RMP (SR) 11 Other (specify) \_\_\_\_\_  
 2 Brass 4 Galvanized steel 6 Concrete tile 9 ABS 12 None used (open hole)  
 SCREEN OR PERFORATION OPENINGS ARE:  
 1 Continuous slot 3 Mill slot 5 Gauzed wrapped  Saw cut 11 None (open hole)  
 2 Louvered shutter 4 Key punched 6 Wire wrapped 9 Drilled holes  
 7 Torch cut 10 Other (specify) \_\_\_\_\_  
 SCREEN-PERFORATED INTERVALS: From 426 ft. to 526 ft., From \_\_\_\_\_ ft. to \_\_\_\_\_ ft.  
 From \_\_\_\_\_ ft. to \_\_\_\_\_ ft., From \_\_\_\_\_ ft. to \_\_\_\_\_ ft.  
 GRAVEL PACK INTERVALS: From 14 ft. to 526 ft., From \_\_\_\_\_ ft. to \_\_\_\_\_ ft.  
 From \_\_\_\_\_ ft. to \_\_\_\_\_ ft., From \_\_\_\_\_ ft. to \_\_\_\_\_ ft.

6 GROUT MATERIAL:  Neat cement 2 Cement grout 3 Bentonite 4 Other \_\_\_\_\_  
 Grout Intervals: From 4 ft. to 14 ft., From \_\_\_\_\_ ft. to \_\_\_\_\_ ft., From \_\_\_\_\_ ft. to \_\_\_\_\_ ft.  
 What is the nearest source of possible contamination:  
 1 Septic tank 4 Lateral lines 7 Pit privy 10 Livestock pens  Abandoned water well  
 2 Sewer lines 5 Cess pool 8 Sewage lagoon 11 Fuel storage 15 Oil well/Gas well  
 3 Watertight sewer lines 6 Seepage pit 9 Feedyard 12 Fertilizer storage 16 Other (specify below)  
 13 Insecticide storage \_\_\_\_\_  
 Direction from well? South How many feet? 30

| FROM | TO  | LITHOLOGIC LOG                  | FROM | TO | LITHOLOGIC LOG |
|------|-----|---------------------------------|------|----|----------------|
| 0    | 7   | 01 Topsoil                      |      |    |                |
| 7    | 210 | Fine to Med. Sand, Clay Streaks |      |    |                |
| 210  | 400 | 04 Clay w/Fine Sand Streaks     |      |    |                |
| 400  | 410 | 07 Fine Sand                    |      |    |                |
| 410  | 455 | 01 Blue Clay                    |      |    |                |
| 455  | 548 | 05 Med. to Lar. Sand            |      |    |                |

7 CONTRACTOR'S OR LANDOWNER'S CERTIFICATION: This water well was (1) constructed, (2) reconstructed, or (3) plugged under my jurisdiction and was completed on (mo/day/year) July 22, 1983 and this record is true to the best of my knowledge and belief. Kansas Water Well Contractor's License No. 252 This Water Well Record was completed on (mo/day/year) July 28, 1983 under the business name of Friesen Windmill & Supply, Inc. by (signature) [Signature]

INSTRUCTIONS: Use typewriter or ball point pen, PLEASE PRESS FIRMLY and PRINT clearly. Please fill in blanks, underline or circle the correct answers. Send top three copies to Kansas Department of Health and Environment, Division of Environment, Environmental Geology Section, Topoka, KS 66620. Send one to WATER WELL OWNER and retain one for your records.

OFFICE USE ONLY  
T  
R  
SEC.