WATER WELL RECORD Form WWC-5 KSA 82a-1212

1 LOCATION OF WATER WELL: County: Stevens | Fraction: SE ¼ NE ¼ SE ¼ | Section Number: 14 | Township Number: T 34 (S) | Range Number: R 36 (E/W)

Distance and direction from nearest town or city street address of well if located within city?

From Woods: 6 W, 6 S, 1 E, ½ N and W into--

2 WATER WELL OWNER: Mobil Oil Corp.

RR#, St. Address, Box # : P.O. Box 5444

City, State, ZIP Code : Denver, Co. 80217

Board of Agriculture, Division of Water Resources Application Number: T87-279

3 LOCATE WELL'S LOCATION WITH AN "X" IN SECTION BOX:

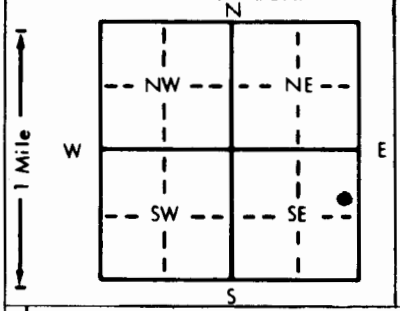

4 DEPTH OF COMPLETED WELL 650 ft. ELEVATION:

Depth(s) Groundwater Encountered 1. 160 ft. 2. ft. 3. ft.

WELL'S STATIC WATER LEVEL 160 ft. below land surface measured on mo/day/yr 7-15-87

Pump test data: Well water was 170 ft. after 1 hours pumping 95 gpm

Est. Yield 95 gpm: Well water was ft. after hours pumping gpm

Bore Hole Diameter 11 in. to 650 ft., and in. to ft.

WELL WATER TO BE USED AS: 5 Public water supply 8 Air conditioning 11 Injection well; 1 Domestic 3 Feedlot (6) Oil field water supply 9 Dewatering 12 Other (Specify below); 2 Irrigation 4 Industrial 7 Lawn and garden only 10 Observation well

Was a chemical/bacteriological sample submitted to Department? Yes No X; If yes, mo/day/yr sample was submitted Water Well Disinfected? Yes X No

5 TYPE OF BLANK CASING USED: 1 Steel 3 RMP (SR) 5 Wrought iron 8 Concrete tile; (2) PVC 4 ABS 6 Asbestos-Cement 9 Other (specify below) 7 Fiberglass

CASING JOINTS: Glued X Clamped Welded Threaded

Blank casing diameter 6 in. to 650 ft., Dia in. to ft., Dia in. to ft.

Casing height above land surface 24 in., weight lbs./ft. Wall thickness or gauge No. .320

TYPE OF SCREEN OR PERFORATION MATERIAL: 1 Steel 3 Stainless steel 5 Fiberglass (7) PVC 10 Asbestos-cement; 2 Brass 4 Galvanized steel 6 Concrete tile 8 RMP (SR) 9 ABS 11 Other (specify) 12 None used (open hole)

SCREEN OR PERFORATION OPENINGS ARE: 1 Continuous slot 3 Mill slot 5 Gauzed wrapped (8) Saw cut 11 None (open hole); 2 Louvered shutter 4 Key punched 6 Wire wrapped 9 Drilled holes 7 Torch cut 10 Other (specify)

SCREEN-PERFORATED INTERVALS: From 550 ft. to 650 ft., From ft. to ft.

From ft. to ft., From ft. to ft.

GRAVEL PACK INTERVALS: From 460 ft. to 650 ft., From ft. to ft.

From ft. to ft., From ft. to ft.

6 GROUT MATERIAL: (1) Neat cement 2 Cement grout 3 Bentonite (4) Other dirt

Grout Intervals: From 1 ft. to 15 ft., From ft. to ft., From ft. to ft.

What is the nearest source of possible contamination: 1 Septic tank 4 Lateral lines 7 Pit privy 10 Livestock pens 14 Abandoned water well; 2 Sewer lines 5 Cess pool 8 Sewage lagoon 11 Fuel storage (15) Oil well/Gas well; 3 Watertight sewer lines 6 Seepage pit 9 Feedyard 12 Fertilizer storage 16 Other (specify below) 13 Insecticide storage

Direction from well? Northwest How many feet? 150

FROM	TO	LITHOLOGIC LOG	FROM	TO	LITHOLOGIC LOG
0	11	Sandy Clay	640	650	Sand
11	50	Clay			
50	72	Sandy Clay			
72	85	Sand			
85	170	Sandy Clay			
170	250	Clay			
250	430	Sandy Clay			
430	510	Clay			
510	555	Sandy Clay			
555	563	Fine Sand			
563	580	Sandy Clay			
580	590	Sand			
590	620	Sandy Clay			
620	632	Sand			
632	640	Sandy Clay			

7 CONTRACTOR'S OR LANDOWNER'S CERTIFICATION: This water well was (1) constructed, (2) reconstructed, or (3) plugged under my jurisdiction and was completed on (mo/day/year) 7-17-87 and this record is true to the best of my knowledge and belief. Kansas Water Well Contractor's License No. KWWCL-430 This Water Well Record was completed on (mo/day/yr) 7-17-87 under the business name of Howard Drlg. Co. Box 806 Beaver, OK 73932 by (signature)

INSTRUCTIONS: Use typewriter or ball point pen, *PLEASE PRESS FIRMLY* and *PRINT* clearly. Please fill in blanks, underline or circle the correct answers. Send top three copies to Kansas Department of Health and Environment, Division of Environment, Environmental Geology Section, Topeka, KS 66620. Send one to WATER WELL OWNER and retain one for your records.

OFFICE USE ONLY T R E/W SEC. ¼ ¼ ¼