


USE TYPEWRITER OR BALL POINT PEN-PRESS FIRMLY, PRINT CLEARLY.

WATER WELL RECORD
KSA 82a-1201-1215

Kansas Department of Health and Environment-Division of Environment (Water well Contractors) Topeka, Kansas 66620


2. Distance and direction from nearest town or city: SE - 5 1/2 S 3. Owner of well: Donald Kinser
Street address of well location if in city: HUGOTON, Ka R.R. or street: R-R.
City, state, zip code: HUGOTON, Ka. 67951

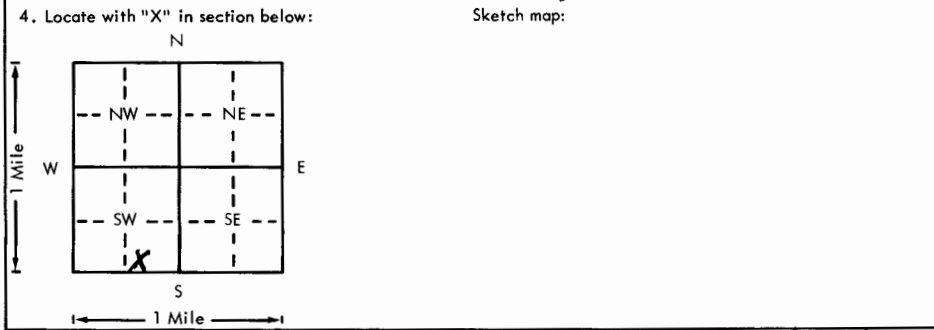

6. Bore hole dia. 10 in. Completion date 4-20-78
Well depth 300 ft.
7. Cable tool Rotary Driven Dug
 Hollow rod Jetted Bored Reverse rotary
8. Use: Domestic Public supply Industry
 Irrigation Air conditioning Stock
 Lawn Oil field water Other
9. Casing: Material _____ Height: Above or below
Threaded _____ Welded _____ Surface 20 in.
RMP _____ PVC 5/8 HD Weight _____ lbs./ft.
Dia. 5 in. to 300 ft. depth Wall Thickness: inches or
Dia. _____ in. to _____ ft. depth gage No. 250

5. Type and color of material	From	To
dark silt	0	22
silts tan w/ some sand	22	30
clays brown sticky	30	54
sand + joint clays brown	54	60
sand coarse + Gravel fine	60	72
clays w/ gravel's sandy	72	100
u redish brown	100	135
sand - coarse w/ gravel some clays	135	145
clays tan + redish	145	194
sand coarse + Gravel w/ some clays	194	200
clays w/ calcitic stringers chaty	200	240
clay ball	240	280
sand coarse w/ gravel fine	280	300
clay ball + sand fine	300	320

10. Screen: Manufacturer's name Slocum
Type Saw cut Dia. 5"
Slot/gauze 1/8 Length 40
Set between 220 ft. and 240 ft.
280 ft. and 300 ft.
Gravel pack? Size range of material 1/4 - 1/2
11. Static water level: _____ mo./day/yr.
130 ft. below land surface Date 4-19-78
12. Pumping level below land surfaces:
_____ ft. after _____ hrs. pumping _____ g.p.m.
_____ ft. after _____ hrs. pumping _____ g.p.m.
Estimated maximum yield _____ g.p.m.
13. Water sample submitted: _____ mo./day/yr.
Yes No Date _____
14. Well head completion:
 Pitless adapter 20 Inches above grade
15. Well grouted?
With: _____ Neat cement _____ Bentonite Concrete
Depth: From 3 ft. to 13 ft.
16. Nearest source of possible contamination:
ft. 150 Direction South Type SEPTIC
Well disinfected upon completion? Yes No
17. Pump: _____ Not installed
Manufacturer's name Reda
Model number 14DIRP HP 1 1/2 Volts 230
Length of drop pipe 180 ft. capacity 22 g.p.m.
Type:
 Submersible Turbine
 Jet Reciprocating
 Centrifugal Other

18. Elevation: _____
19. Remarks: _____
Topography:
 Hill
 Slope
 Upland
 Valley

20. Water well contractor's certification:
This well was drilled under my jurisdiction and this report is true to the best of my knowledge and belief.
Slocum Drilling 127
Business name License No. _____
Address HUGOTON, KA 67951
Signed Paul Slocum Date 4-30
Authorized representative

78
34
36
17
SWSE
1/4 1/4 N 1/4