


1 LOCATION OF WATER WELL: County: **Stevens** Fraction: **SE 1/4 SE 1/4 SE 1/4** Section Number: **22** Township Number: **T 34 S** Range Number: **R 36 E/W**

Distance and direction from nearest town or city street address of well if located within city?
8 East, 7 South of Hugoton, Kansas

2 WATER WELL OWNER: **Mr. Frank Thomas**
 RR#, St. Address, Box #: **RFD #1** Board of Agriculture, Division of Water Resources
 City, State, ZIP Code: **Hugoton, Kansas 67951** Application Number: **---**

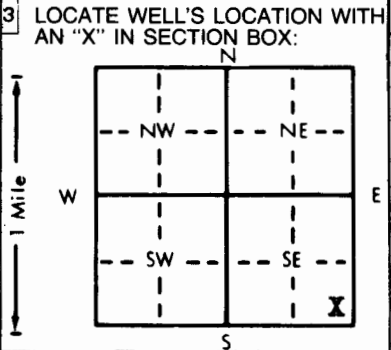

4 DEPTH OF COMPLETED WELL: **413** ft. ELEVATION: **South**
 Depth(s) Groundwater Encountered: 1. **180** ft. 2. **240** ft. 3. **350** ft.
 WELL'S STATIC WATER LEVEL: **137** ft. below land surface measured on mo/day/yr **April 7, 1982**
 Pump test data: Well water was _____ ft. after _____ hours pumping _____ gpm
 Est. Yield: **100** gpm; Well water was _____ ft. after _____ hours pumping _____ gpm
 Bore Hole Diameter: **9 7/8** in. to **413** ft., and _____ in. to _____ ft.
 WELL WATER TO BE USED AS:
 Domestic Feedlot Oil field water supply Dewatering Other (Specify below)
 Irrigation Industrial Lawn and garden only Observation well
 Was a chemical/bacteriological sample submitted to Department? Yes _____ No **XX**; If yes, mo/day/yr sample was submitted _____
 Water Well Disinfected? Yes **XX** No _____

5 TYPE OF BLANK CASING USED:
 Steel RMP (SR) Wrought iron Concrete tile CASING JOINTS: Glued **XX** Clamped _____
 PVC ABS Asbestos-Cement Other (specify below) Welded _____
 Fiberglass Threaded _____
 Blank casing diameter: **5** in. to **353** ft., Dia. _____ in. to _____ ft., Dia. _____ in. to _____ ft.
 Casing height above land surface: **12** in., weight **2.8** lbs./ft. Wall thickness or gauge No. **.265**

TYPE OF SCREEN OR PERFORATION MATERIAL:
 Steel Stainless steel Fiberglass RMP (SR) Asbestos-cement
 Brass Galvanized steel Concrete tile ABS Other (specify) _____
 None used (open hole)

SCREEN OR PERFORATION OPENINGS ARE:
 Continuous slot Mill slot Gauzed wrapped Saw cut None (open hole)
 Louvered shutter Key punched Wire wrapped Drilled holes
 Torch cut Other (specify) _____

SCREEN-PERFORATED INTERVALS: From **353** ft. to **413** ft., From _____ ft. to _____ ft.
 From _____ ft. to _____ ft., From _____ ft. to _____ ft.
 GRAVEL PACK INTERVALS: From **14** ft. to **413** ft., From _____ ft. to _____ ft.
 From _____ ft. to _____ ft., From _____ ft. to _____ ft.

6 GROUT MATERIAL: Neat cement Cement grout Bentonite Other _____
 Grout Intervals: From **4** ft. to **14** ft., From _____ ft. to _____ ft., From _____ ft. to _____ ft.
 What is the nearest source of possible contamination:
 Septic tank Lateral lines Pit privy Livestock pens Abandoned water well
 Sewer lines Cess pool Sewage lagoon Fuel storage Oil well/Gas well
 Watertight sewer lines Seepage pit Feedyard Fertilizer storage Other (specify below)
 Insecticide storage
 Direction from well? **South** How many feet? **85**

FROM	TO	LITHOLOGIC LOG	FROM	TO	LITHOLOGIC LOG
0	3	Topsoil			
3	8	Clay			
8	12	Fine Sand			
12	50	Clay			
50	95	Fine Sand			
95	180	Clay & Loose White Sugar Sand			
180	200	Fine Sand			
200	240	Clay			
240	320	Very Fine Sugar Sand			
320	350	Clay			
350	420	Medium Sand			

7 CONTRACTOR'S OR LANDOWNER'S CERTIFICATION: This water well was (1) constructed, (2) reconstructed, or (3) plugged under my jurisdiction and was completed on (mo/day/year) **April 9, 1982** and this record is true to the best of my knowledge and belief. Kansas Water Well Contractor's License No. **252** This Water Well Record was completed on (mo/day/year) **April 22, 1982** under the business name of **Frisson Windmill & Supply Inc.** by (signature) _____

INSTRUCTIONS: Use typewriter or ball point pen, PLEASE PRESS FIRMLY and PRINT clearly. Please fill in blanks, underline or circle the correct answers. Send top three copies to Kansas Department of Health and Environment, Division of Environment, Environmental Geology Section, Topeka, KS 66620. Send one to WATER WELL OWNER and retain one for your records.

OFFICE USE ONLY
T
34
R
36
EWD
SEC.
22
SE 1/4
SE 1/4
SE 1/4