WATER WELL RECORD Form WWC-5 KSA 82a-1212

1 LOCATION OF WATER WELL: County: Stevens | Fraction: SW ¼ NE ¼ NE ¼ | Section Number: 27 | Township Number: T 34 S | Range Number: R 36 E/W

Distance and direction from nearest town or city street address of well if located within city?
2nd Street and Moscow Road 2 North ½ West South into

2 WATER WELL OWNER: Morford 1-27 Ensign Operating CO
RR#, St. Address, Box # : 621 17th Street #1800
City, State, ZIP Code : Denver, CO 80293
Board of Agriculture, Division of Water Resources Application Number: 910046

3 LOCATE WELL'S LOCATION WITH AN "X" IN SECTION BOX:

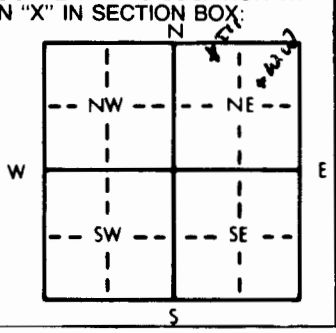

4 DEPTH OF COMPLETED WELL: 260 ft. ELEVATION:
Depth(s) Groundwater Encountered 1. 122 ft. 2. ft. 3. ft.
WELL'S STATIC WATER LEVEL 138 ft. below land surface measured on mo/day/yr 1-25-91
Pump test data: Well water was 130 ft. after 2 hours pumping 65 gpm
Est. Yield 70 gpm: Well water was ft. after hours pumping gpm
Bore Hole Diameter 9 in. to 260 ft., and in. to ft.
WELL WATER TO BE USED AS: 5 Public water supply 8 Air conditioning 11 Injection well
1 Domestic 3 Feedlot ~~6 Oil field water supply~~ 9 Dewatering 12 Other (Specify below)
2 Irrigation 4 Industrial 7 Lawn and garden only 10 Monitoring well
Was a chemical/bacteriological sample submitted to Department? Yes No X; If yes, mo/day/yr sample was submitted
Water Well Disinfected? Yes X No

5 TYPE OF BLANK CASING USED: 5 Wrought iron 8 Concrete tile CASING JOINTS: Glued X Clamped
1 Steel 3 RMP (SR) 6 Asbestos-Cement 9 Other (specify below) Welded
2 PVC 4 ABS 7 Fiberglass Threaded
Blank casing diameter 5 in. to 160 ft., Dia in. to ft., Dia in. to ft.
Casing height above land surface 14 in., weight 200 lbs./ft. Wall thickness or gauge No. 0.265
TYPE OF SCREEN OR PERFORATION MATERIAL: 7 PVC 10 Asbestos-cement
1 Steel 3 Stainless steel 5 Fiberglass 8 RMP (SR) 11 Other (specify)
2 Brass 4 Galvanized steel 6 Concrete tile 9 ABS 12 None used (open hole)
SCREEN OR PERFORATION OPENINGS ARE: 5 Gauzed wrapped ~~8 Saw cut~~ 11 None (open hole)
1 Continuous slot 3 Mill slot 6 Wire wrapped 9 Drilled holes
2 Louvered shutter 4 Key punched 7 Torch cut 10 Other (specify)
SCREEN-PERFORATED INTERVALS: From 160 ft. to 260 ft., From ft. to ft.
From ft. to ft., From ft. to ft.
GRAVEL PACK INTERVALS: From 130 ft. to 260 ft., From ft. to ft.
From ft. to ft., From ft. to ft.

6 GROUT MATERIAL: 1 Neat cement 2 Cement grout 3 Bentonite 4 Other Hole plug
Grout Intervals: From 0 ft. to 20 ft., From ft. to ft., From ft. to ft.
What is the nearest source of possible contamination: 10 Livestock pens 14 Abandoned water well
1 Septic tank 4 Lateral lines 7 Pit privy 11 Fuel storage ~~15 Oil well/Gas well~~
2 Sewer lines 5 Cess pool 8 Sewage lagoon 12 Fertilizer storage 16 Other (specify below)
3 Watertight sewer lines 6 Seepage pit 9 Feedyard 13 Insecticide storage
Direction from well? Southwest How many feet? 250

FROM	TO	LITHOLOGIC LOG	FROM	TO	PLUGGING INTERVALS
0	138	Overburden			
138	180	Fine sand and clay			
180	200	Medium sand			
200	220	Medium sand and clay			
220	240	Medium sand			
240	260	Medium and coarse sand			

7 CONTRACTOR'S OR LANDOWNER'S CERTIFICATION: This water well was (1) constructed, (2) reconstructed, or (3) plugged under my jurisdiction and was completed on (mo/day/year) 1-25-91 and this record is true to the best of my knowledge and belief. Kansas Water Well Contractor's License No. 142 This Water Well Record was completed on (mo/day/yr) 2-4-91
under the business name of T & W Water Well Service, Inc. by (signature) C D Wagenseller

INSTRUCTIONS: Use typewriter or ball point pen. *PLEASE PRESS FIRMLY* and *PRINT* clearly. Please fill in blanks, underline or circle the correct answers. Send top three copies to Kansas Department of Health and Environment, Bureau of Water, Topeka, Kansas 66620-7320. Telephone: 913-296-5545. Send one to WATER WELL OWNER and retain one for your records.

OFFICE USE ONLY T R E/W SEC. ¼ ¼ ¼